IREDELL COUNTY HEALTH DEPARTMENT

STATESVILLE 704-878-5305 MOORESVILLE 704-664-5281

IMPROVEMENT PERMIT / AUTHORIZATION TO CONSTRUCT / OPERATION PERMIT / EXISTING SYSTEM INSPECTION

PERMIT# 090725 PIN# 4811 11 0577 DATE 7-3-2000

OWNER OR CONTRACTOR RANDY SHOEMAKER PHONE: Business _____ Home 592-5049

ADDRESS 130 SHOEMAKER FARM RD, STATESVILLE, NC 28625

LOCATION NC 115 N, TL MTN. VIEW RD, TL BROOKHAVEN RD, TL SHUMAKER (130), TL ADELINE, BACK

SUBDIVISION _____ BLOCK / SECTION _____ LOT _____ LOT AREA 35.45 ACRES SITE CLASS PS DESIGN FLOW 360 L.T.A.R. 0.40 GPD/FT²

Septic Tank: 1000 Gallons; STB 1012 Date 4-24-00
Pump Tank: _____ Gallons; PT _____ Date _____
Pump Make: _____ Model _____ Serial No. _____
Nitrification Field: No Fields 1 Square Feet 900 Linear Feet 300
No Lines Four Trench Width 36" Max Trench Bottom Depth 36" Gravel Depth 12"

☑ New System ☐ Repair System Type: I II III IV V VI
System Description: CONVENTIONAL GRAVITY
Repair System Description: CONV. GRAVITY
Maintenance Agreement Required: ☐ Yes ☑ No
☐ Slab ☑ Crawl Space ☐ Basement w/plumbing ☐ Basement wo/plumbing


☐ House/Mod. Home No. Bedrooms 3
☑ Mobile Home No. Bathrooms 2
☐ Business No. Employees ____
☐ Other _____

Water Supply: ☑ Individual ☐ Public ☐ Community
WELL

Comments/Conditions: KEEP SYSTEM MINIMUM 100 FEET FROM WELL -.1956 (6)(a)

Comments/Conditions: SEPTIC TANK W/ RISERS INSTALLED USING "POLYLOK" FILTER

INITIAL SITE SKETCH SCALE: 1" = 40'

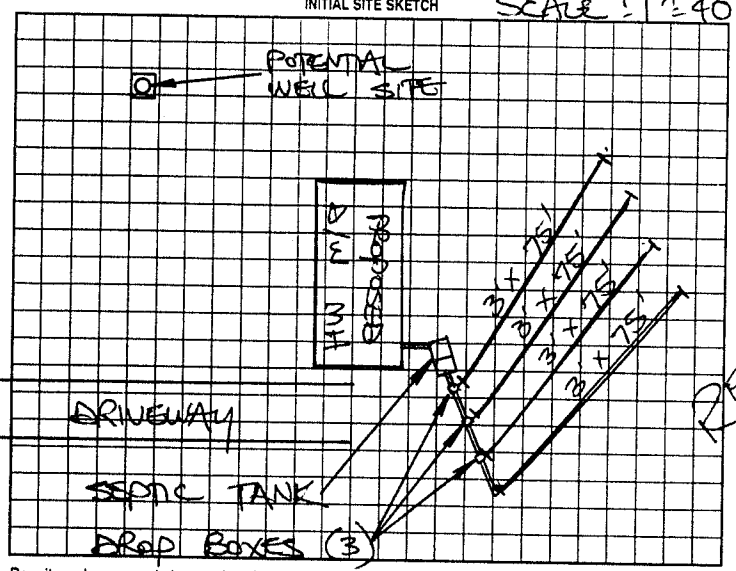

AS BUILT SKETCH

SYSTEM INSTALLED ACCORDING TO INITAL SITE SKETCH

Permit can be suspended or revoked if any false information is supplied toward securing the permit/any unauthorized changes are made to the site/any unauthorized changes are made in the installation of the system. Improvement Permit with plat valid without expiration. Improvement Permit with site plan valid for sixty months. Authorization to Construct is valid for a period equal to that of Improvement Permit – not to exceed sixty months.

Signed: Randy D Shoemaker date 7-3-00 Installed by: LEVI NANCE

Improvement Permit by: STEVE HEDRICK date 7-3-2000 Operation Permit by: STEVE HEDRICK date 7-7-2000

Authorization to Construct by: STEVE HEDRICK date 7-3-2000 Existing System Inspection by: _____ date _____

HEALTH DEPT. COPY: WHITE OWNER COPY (FINAL): YELLOW OWNER COPY (INITIAL): PINK