52555

THIS PERMIT VOIDS PREVIOUS ISSUED 4/14/94

IREDELL COUNTY HEALTH DEPARTMENT

STATESVILLE 704-878-5305 MOORESVILLE 704-664-5281

50479?

IMPROVEMENT PERMIT / CERTIFICATE OF COMPLETION / OPERATION PERMIT / EXISTING SYSTEM INSPECTION

PROPERTY DESCRIPTION NO. 18253 DATE 9/30/94 TAX MAP NO. 15D-A-56 (PART OF) Watershed: ☐ Yes ☑ No

OWNER OR CONTRACTOR MICHAEL J. CARUSO PHONE: Business (704) 323-0825 Home 466-2774

ADDRESS RT. 3, BOX 718, CONOVER, NC 28613

LOCATION NC 115 N, TL MTN. VIEW RD, TR LOVE VALLEY RD, ON LEFT ~800' PAST FOX MOUNTAIN ROAD

SUBDIVISION _____ BLOCK / SECTION _____ LOT _____ LOT AREA ~100' x 230' SITE CLASS. PS DESIGN FLOW 360 L.T.A.R. 0.33 GPD/FT2

Septic Tank: 1000 Gallons; STB 1012 Date 1/27/95

~~Pump Tank:~~ 1000 Gallons; PT _____ Date _____

Pump Make: _____ Model _____ Serial No. _____

Nitrification Field: No Fields 1 Square Feet 1080 Linear Feet 360

No Lines 4 Trench Width 36" Max Trench Bottom Depth 36" Gravel Depth 12"

☑ New System ☐ Repair System Type: I, II, III, IV, V, VI

System Description: PUMP TO MANIFOLD / CONV.

Repair System Description: PUMP TO MANIFOLD/CONV.

Maintenance Agreement Required: ☐ Yes ☑ No

☑ House/Mod. Home ☐ Mobile Home ☐ Business ☐ Other

No. Bedrooms 3 No. Bathrooms 2½ No. Employees ____


☐ Slab ☐ Crawl Space ☑ ~~Basement w/plumbing~~ ☑ Basement wo/plumbing

Water Supply: ☑ Individual ☐ Community ☐ Public WELL


Comments: ① KEEP SYSTEM MINIMUM 5' FROM HOUSE, 15' FROM BASEMENT, 10' FROM PROPERTY LINE, 50' FROM WELL ② INSTALL PRESSURE MANIFOLD AS SHOWN USING 4 x 3/4" TAPS ③ USE PUMP SIZED TO DELIVER 48 GPM AT 20 TDH

Comments: SYSTEM INSTALLED DEEP AT UPPER TWO LINES - CHANGED TO BASEMENT W/O PLUMBING

INITIAL SITE SKETCH

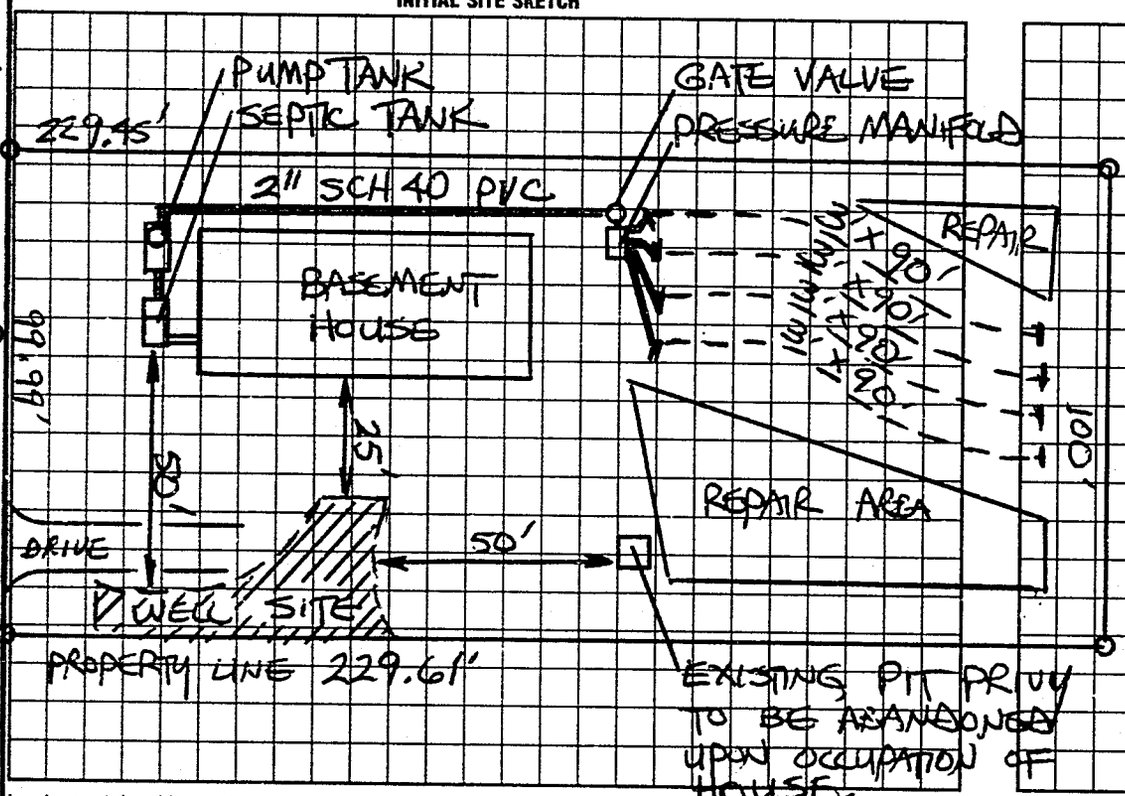

AS BUILT SKETCH

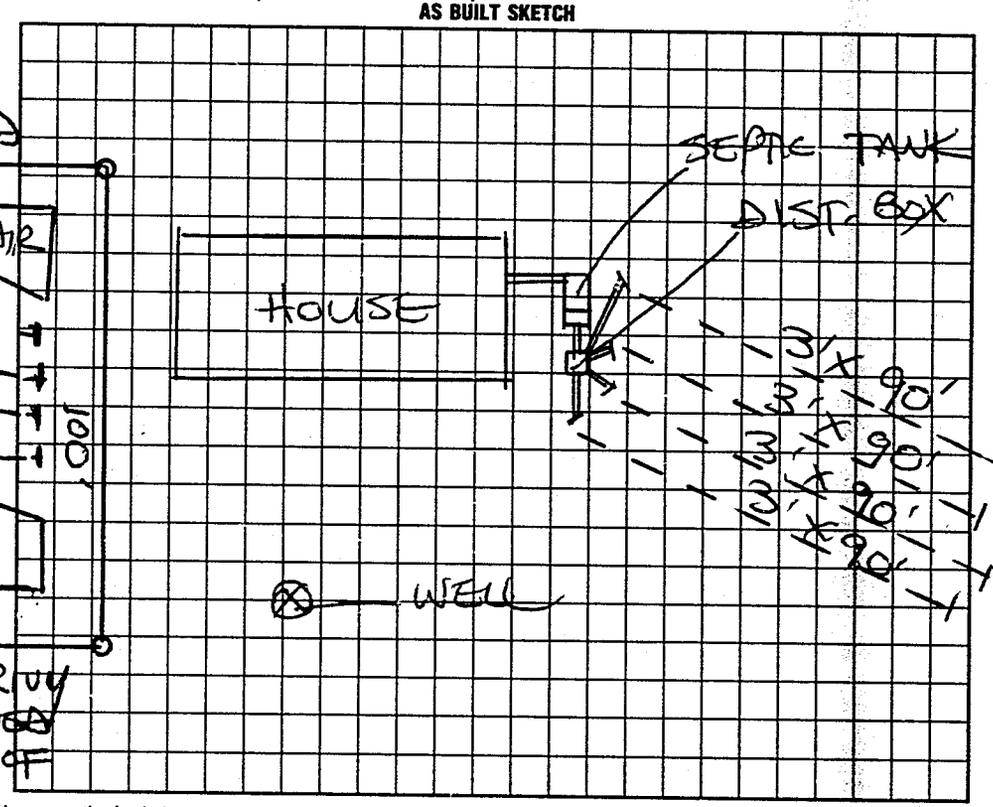

LOVE VALLEY ROAD (SR 1591)

I understand that this permit can be suspended or revoked if any false information is supplied toward securing the permit/any unauthorized changes are made to the site/any unauthorized changes are made in the installation of the system. Improvement Permit is valid for 60 months from date of issuance.

Signed: + Michael J. Caruso

Improvement Permit by: STEVE HEDRICK date 9/30/94

Existing System Inspection by: _____ date _____

Installed by: + HARRY REEP

Certificate of Completion by: STEVE HEDRICK date 4/6/95

Operation Permit by: STEVE HEDRICK date 4/6/95

HEALTH DEPT. COPY: WHITE INSPECTION COPY (FINAL): GREEN OWNER COPY (FINAL): YELLOW INSPECTION COPY (INITIAL): PINK OWNER COPY (INITIAL): GOLD

THIS PERMIT VOIDS PREVIOUS ISSUED 4/14/94