IREDELL COUNTY HEALTH DEPARTMENT

STATESVILLE 704-878-5305 MOORESVILLE 704-664-5281

IMPROVEMENT PERMIT / AUTHORIZATION TO CONSTRUCT / OPERATION PERMIT / EXISTING SYSTEM INSPECTION

PERMIT# REPAIR PIN# 4811-18-3989 DATE 9-20-05

OWNER OR CONTRACTOR WILLIAM F. ODELL PHONE: Business 336-403-1563 Home 336-731-4501

ADDRESS 2450 REEDY CREEK ROAD, LEXINGTON, NC 27295

LOCATION NC 115 North, TL MOUNTAIN VIEW RD, TR LOVE VALLEY ROAD, TL MITCHELL TRAIL, 2ND LOT ON RIGHT

SUBDIVISION _____ BLOCK / SECTION _____ LOT _____ LOT AREA 0.85 ACRE SITE CLASS PS? DESIGN FLOW 360 L.T.A.R. 0.60 GPD/FT²

Septic Tank: 1500 Gallons; STB 964 Date 7-22-05

Pump Tank: _____ Gallons; PT _____ Date _____

Pump Make: _____ Model _____ Serial No. _____

Nitrification Field: No Fields 1 Square Feet 450 Linear Feet 150

No Lines TWO Trench Width 36" Max Trench Bottom Depth 36"

☒ New System ☒ Repair System Type: I, II, III, IV, V, VI

System Description: _____

Repair System Description: 25% REDUCTION / CONVENTIONAL

Maintenance Agreement Required: ☐ Yes ☒ No

Gravel Depth 15" / N/A ☐ Slab ☒ Crawl Space ☐ Basement w/plumbing ☐ Basement wo/plumbing

☐ House/Mod. Home No. Bedrooms 3

☐ Mobile Home No. Bathrooms ____

☐ Business No. Employees ____

☐ Other 3 CAMPERS


Water Supply: ☐ Individual ☒ Public ☐ Community

Comments/Conditions: ① RELOCATE EXISTING WATER LINES MINIMUM TEN (10) FEET FROM SYSTEM ② INSTALL NEW SEPTIC TANK (1500 GAL) ③ INSTALL NEW LINES ON CONTOUR USING 15" STONE OR 25% REDUCTION SYSTEM

Comments/Conditions: SYSTEM TO BE INSTALLED BY OCTOBER 20, 2005

SEPTIC TANK WITH MARKER INSTALLED USING RED "POLYLOK" FILTER

INITIAL SITE SKETCH

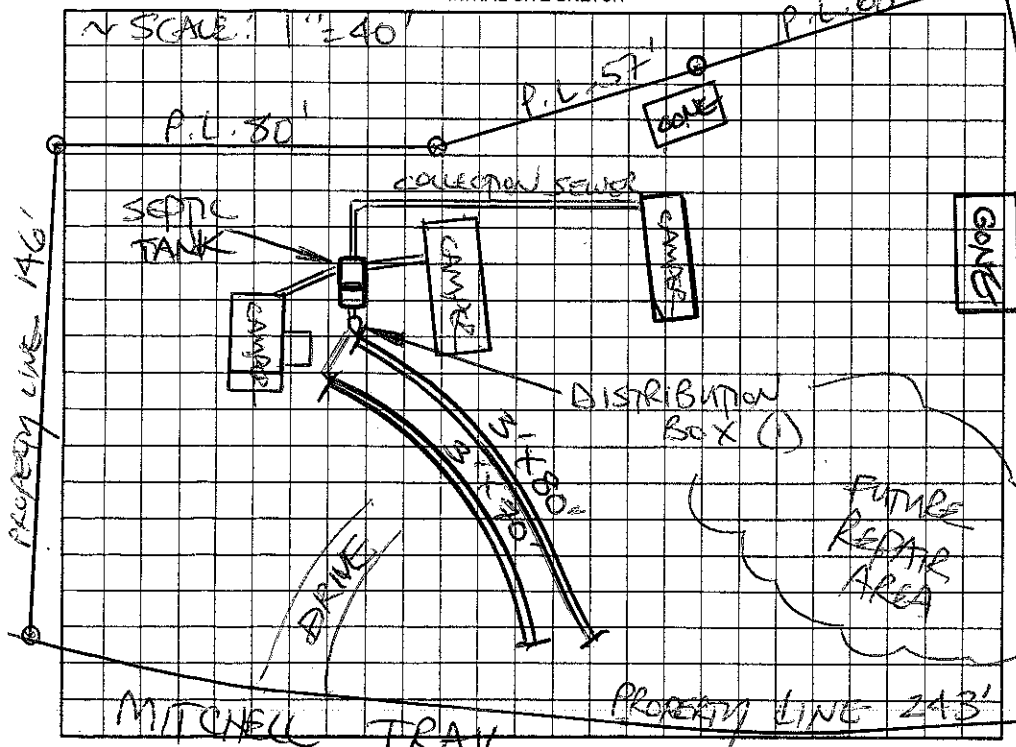

AS BUILT SKETCH

SYSTEM INSTALLED ACCORDING TO INITAL SITE SKETCH

Permit can be suspended or revoked if any false information is supplied toward securing the permit/any unauthorized changes are made to the site/any unauthorized changes are made in the installation of the system. Improvement Permit with plat valid without expiration. Improvement Permit with site plan valid for sixty months. Authorization to Construct is valid for a period equal to that of Improvement Permit – not to exceed sixty months.

Signed: William F Odell date 9-20-05 Installed by: OWNER

Improvement Permit by: STEVE HEDRICK date 9-20-05 Operation Permit by: STEVE HEDRICK date 11-8-05

Authorization to Construct by: STEVE HEDRICK date 9-20-05 Existing System Inspection by: _____ date _____

HEALTH DEPT. COPY: WHITE OWNER COPY (FINAL): YELLOW OWNER COPY (INITIAL): PINK