IREDELL COUNTY HEALTH DEPARTMENT

STATESVILLE 704-878-5305 MOORESVILLE 704-664-5281

IMPROVEMENT PERMIT / AUTHORIZATION TO CONSTRUCT / OPERATION PERMIT / EXISTING SYSTEM INSPECTION

PERMIT # 16536 PIN # 4811 18 4528 DATE March 21, 2011

OWNER or APPLICANT Bobby Cuthbreth PHONE: Business Home:

OWNER or APPLICANT ADDRESS 98 Bonnell, Statesville NC 28625

LOCATION / DIRECTIONS 297 Love Valley Rd 115N TR Mountain View TR Love Valley RD 3/4-1 mile on left

SUBDIVISION BLOCK / SECTION LOT # LOT AREA .59Ac DESIGN FLOW 240gpd L.T.A.R. .25

Septic Tank 1000 Gallons: STB 1012 Date 4-14-11

Pump Tank Gallons: P T Date

Pump Make Model Serial #

Nitrification Field No Fields 1 No Lines 4 Linear Feet 240

Trench Width 36" Max. Trench Bottom Depth ~24" Gravel Depth NA

☒ New System ☐ Repair ☐ Expansion System Type I II (III) IV V VI

System Description: 25% Reduction

Repair System Description: pumped conventional or 25% Red

Maintenance Agreement Required ☐ YES ☒ NO

☒ GRAVITY ☐ PRESSURE

☒ Residence No. Bedrooms 2

☐ Business No. Persons

☐ Other No. Employees

☐ Slab ☐ Crawl Space


☐ Basement w/plumbing ☐ Basement w/o plumbing

Water Supply: ☒ Private ☐ Public ☐ Community

Comments / Conditions: Can use D-box or approved serial distribution methods

Comments / Conditions

INITIAL SITE SKETCH

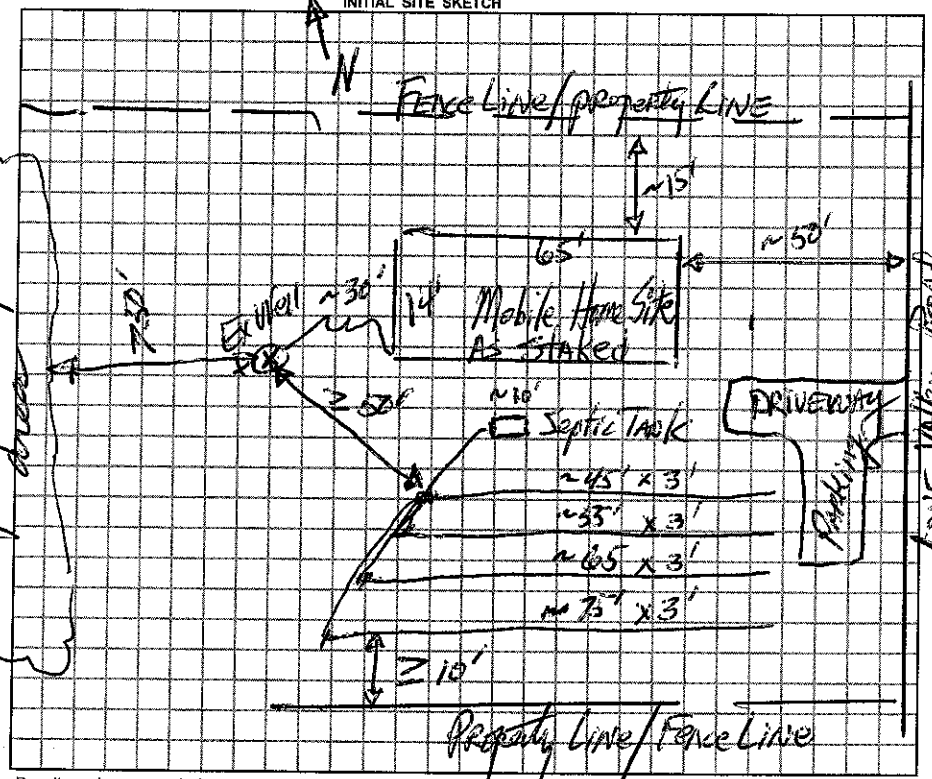

AS BUILT SKETCH

Permit can be suspended or revoked if any false information is supplied toward securing the permit / any unauthorized changes are made to the site / any unauthorized changes are made in the installation of the system.

☐ *IMPROVEMENT PERMIT w / plat valid without expiration.* ☒ *IMPROVEMENT PERMIT w / site plan valid for 60 mos.* ☒ *AUTHORIZATION TO CONSTRUCT valid for period equal to IMPROVEMENT PERMIT-not to exceed 60 mo.*

Owner / Applicant Signature: X Bobby C. Cuthbreth Date 3-21-11

Improvement Permit by: Tamara REHS Date 3-21-11

Authorzation to Construct by: Tamara REHS Date 3-21-11

YOU SHOULD CONTACT A LOCATOR SERVICE PRIOR TO ANY EXCAVATION.

Installed by: Andy Davis

Operation Permit by: Tamara Date: 4-20-11

Existing System Inspected by: Date:

WHITE COPY Environmental Health YELLOW COPY (Final) Owner / Applicant PINK COPY (Initial) Owner / Applicant