8/24/98 Pd. Receipt No. 141158

IREDELL COUNTY HEALTH DEPARTMENT

STATESVILLE 704-878-5305 MOORESVILLE 704-664-5281

IMPROVEMENT PERMIT / AUTHORIZATION TO CONSTRUCT / OPERATION PERMIT / EXISTING SYSTEM INSPECTION

PERMIT# 073684 PIN# 4811 18 6477 DATE 8-24-98

OWNER OR CONTRACTOR JAMES ANGEL PHONE: Business Home (336) 998-5339

ADDRESS 963 FARMINGTON ROAD, MOCKSVILLE, NC 28697

LOCATION NC 115 N, TL MTN. VIEW ROAD, TR LOVE VALLEY RD, 1ST DRIVE ON RIGHT PAST PLESS ROAD.

SUBDIVISION BLOCK / SECTION LOT E LOT AREA 1.00 SITE CLASS PS DESIGN FLOW 240 L.T.A.R. 0.33 GPD/FT²

Septic Tank: 1000 Gallons; STB 312 Date 7-4-03
Pump Tank: Gallons; PT Date
Pump Make: Model Serial No.
Nitrification Field: No Fields 1 Square Feet 720 Linear Feet 240
No Lines THREE Trench Width 36" Max Trench Bottom Depth 36" Gravel Depth 12"

☑ New System ☐ Repair System Type: I, II, III, IV, V, VI
System Description: CONVENTIONAL GRAVITY
Repair System Description: CONV. GRAVITY PUMP
Maintenance Agreement Required: ☐ Yes ☑ No


☑ House/Mod. Home No. Bedrooms 2
☐ Mobile Home No. Bathrooms 1
☐ Business No. Employees
☐ Other
☐ Slab ☑ Crawl Space ☐ Basement w/plumbing ☐ Basement wo/plumbing

Water Supply: ☐ Individual ☑ Public ☐ Community

Comments:/Conditions:

Comments:/Conditions: ZABEL FILTER & MARKER S/W ON LOT NOW. MAY BUILD CABIN. SYSTEM HAS NOT CHANGED & SIZED FOR 2 BEDROOMS.

SCALE: 1"=50' **INITIAL SITE SKETCH**

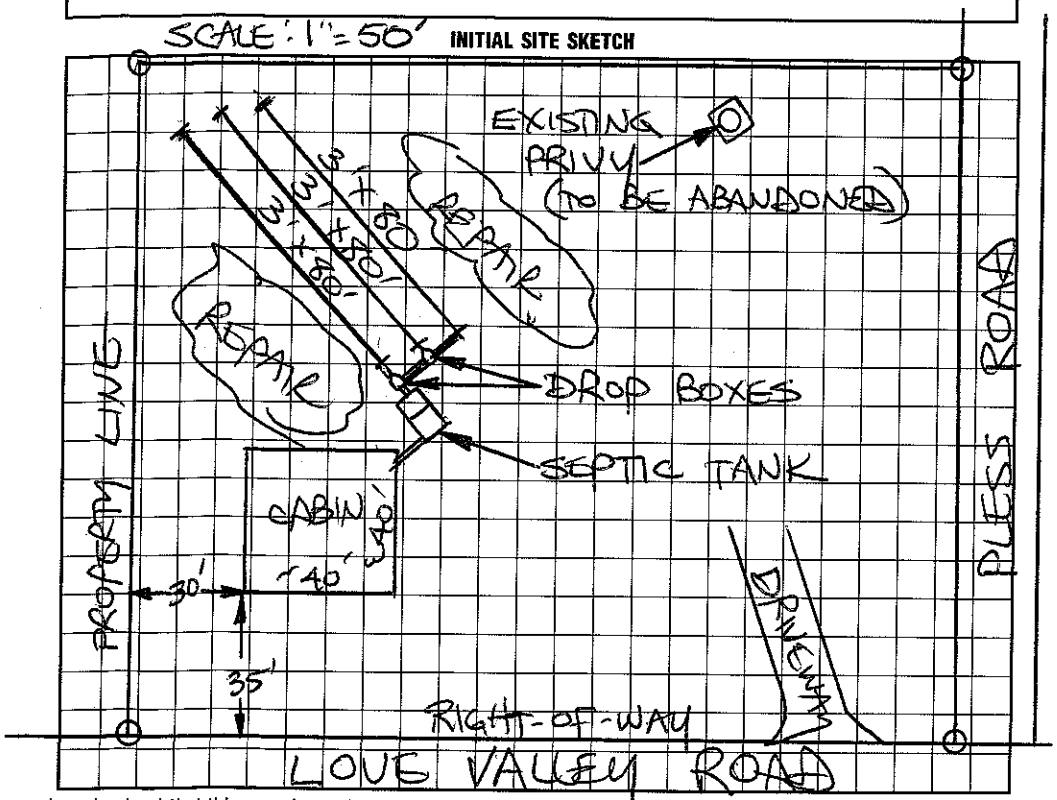

AS BUILT SKETCH

I understand that this permit can be suspended or revoked if any false information is supplied toward securing the permit/any unauthorized changes are made to the site/any unauthorized changes are made in the installation of the system. Improvement Permit with plat valid without expiration. Improvement Permit with site plan valid for sixty months. Authorization to Construct is valid for a period equal to that of Improvement Permit – not to exceed sixty months.

Signed: James L Angel date 8-24-98 Installed by: ANDY DANIELS

Improvement Permit by: STEVE HEDRICK date 8-24-98 Operation Permit by: date 8-10-03

Authorization to Construct by: STEVE HEDRICK date 8-24-98 Existing System Inspection by: date

HEALTH DEPT. COPY: WHITE INSPECTION COPY (FINAL): GREEN OWNER COPY (FINAL): YELLOW INSPECTION COPY (INITIAL): PINK OWNER COPY (INITIAL): GOLD