# IREDELL COUNTY HEALTH DEPARTMENT

STATESVILLE 704-878-5305 MOORESVILLE 704-664-5281

## IMPROVEMENT PERMIT / AUTHORIZATION TO CONSTRUCT / OPERATION PERMIT / EXISTING SYSTEM INSPECTION

PERMIT# LOVEVALLEY PIN# LOVE VALLEY 4811-19-2251 DATE 10-29-03

OWNER OR CONTRACTOR RICK HILDRETH PHONE: Business Home 704-592-2120

ADDRESS 283 FOX MTN RD STATESVILLE, NC 28625

LOCATION 115 N, (D) MOUNTAINVIEW RD (B) LOVE VALLEY RD (E) MITCHELL TRAIL 1/2 mile on RT

SUBDIVISION BLOCK / SECTION LOT LOT AREA AMPLE SITE CLASS. PS DESIGN FLOW 360 L.T.A.R. .3

Septic Tank: 1000 Gallons; STB 144 Date 5-7-03
Pump Tank: Gallons; PT Date
Pump Make: Model Serial No.
Nitrification Field: No Fields 1 Square Feet E.D.=1200 Linear Feet 200'
No Lines 6x33 Trench Width 24" Max Trench Bottom Depth 36" Gravel Depth N/A

☒ New System ☐ Repair System Type: I, II, (III), IV, V, VI
System Description: GRAV PANEL
Repair System Description: LP PANEL
Maintenance Agreement Required: ☐ Yes ☒ No


☐ House/Mod. Home No. Bedrooms 3
☒ Mobile Home DW No. Bathrooms 2
☐ Business No. Employees
☐ Other
☐ Slab ☒ Crawl Space ☐ Basement w/plumbing ☐ Basement wo/plumbing

Water Supply:
☐ Individual
☒ Public
☐ Community

Comments:/Conditions: (1) INSTALL LINES ON CONTOURS (2) MAINTAIN SETBACKS (3) INSTALL 6 LINES, 33' LONG USING 2 DIST BOX'S & 1 FLOW OFF TO DR TREE,

Comments:/Conditions: (4) SYSTEM & HOUSE IS FLAGGED OUT (5) DIVERT SURFACE H2O AS DRAWN ZABEL FILTER & MANHOLE INSTALLED AS DRAWN

INITIAL SITE SKETCH "NOT TO SCALE"

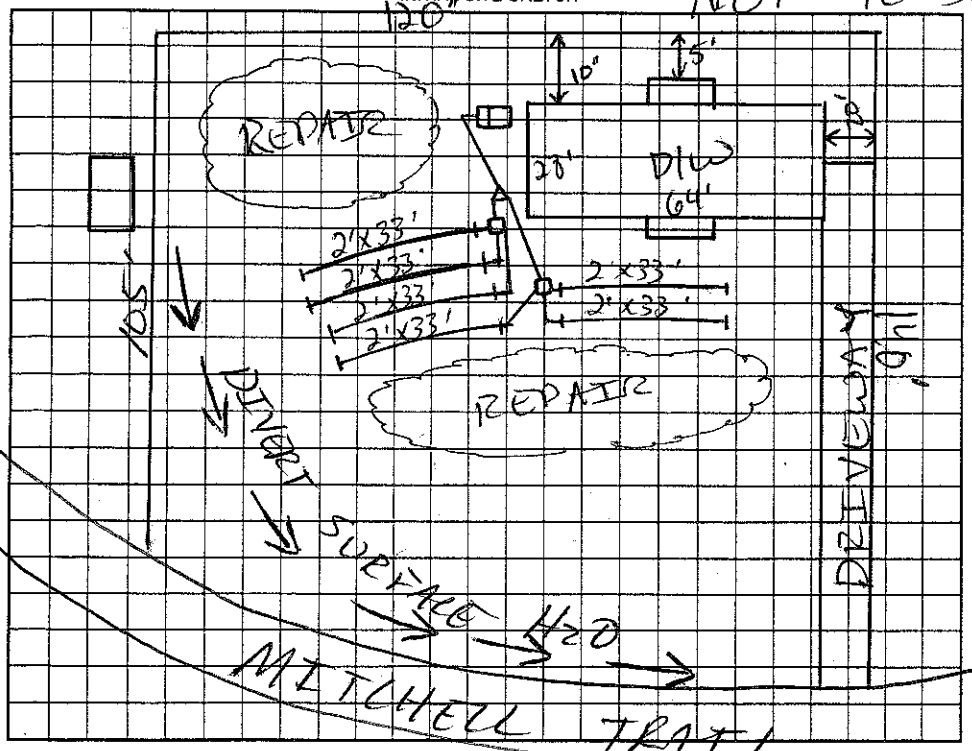


AS BUILT SKETCH

Permit can be suspended or revoked if any false information is supplied ~~toward securing the permit/any unauthorized~~ changes are made to the site/any unauthorized changes are made in the installation of the system. Improvement Permit with plat valid without expiration. Improvement Permit with site plan valid for sixty months. Authorization to Construct is valid for a period equal to that of Improvement Permit – not to exceed sixty months.

Signed: Rick Hildreth date Installed by: DOLLY MADISON GRADING

Improvement Permit by: date 10-30-03 Operation Permit by: date 10-31-03

Authorization to Construct by: date 10-30-03 Existing System Inspection by: date

HEALTH DEPT. COPY: WHITE OWNER COPY (FINAL): YELLOW OWNER COPY (INITIAL): PINK