IREDELL COUNTY HEALTH DEPARTMENT - *ENVIRONMENTAL HEALTH* ☒ STATESVILLE OFFICE 704-878-5305 ☐ MOORESVILLE OFFICE 704-664-5281

IMPROVEMENT PERMIT / AUTHORIZATION TO CONSTRUCT (IP) / OPERATION PERMIT (OP) / EXISTING SYSTEM INSPECTION

PERMIT # 165221 PIN # 4811195238 DATE 2-8-11

OWNER Randy Sauls APPLICANT: PHONE: Home/Cell # 919 772 1497 Business #

SITE ADDRESS 106 Godfrey Lane OWNER / APPLICANT ADDRESS 8720 Crowder Rd, Raleigh, NC 27603

SITE DIRECTIONS 115N to (L) on Mtn. View, (R) on Love Valley Rd, (L) on Godfrey Pass, property on (R)

SUBDIVISION n/a BLOCK / SECTION n/a LOT # n/a LOT AREA 103 x 100 DESIGN FLOW 240 L.T.A.R. 3

Septic Tank 1000 Gallons: STB (ELOVAD) 620 Date 5-12-08 ☒ New System ☐ Repair ☐ Expansion System Type I II III IV V VI ☒ Residence No. Bedrooms 2 Water Supply

Pump Tank ____ Gallons: P T ____ Date ____ System Description: 50% Reduction Gravity ☐ Business No. Persons ____ ☐ Private


Pump Make ____ Model ____ Serial # ____ Repair System Description: 50% ☐ Other No. Employees ____ ☒ Public

No. Nitrification Fields: 1 No. Lines 3 Linear Feet 134' Maintenance Agreement Required ☐ YES ☒ NO ☐ Slab ☒ Crawl Space ☐ Community

Trench Width 24" Max. Trench Bottom Depth 36" Gravel Depth n/a ☒ GRAVITY ☐ PRESSURE ☐ Basement w/plumbing ☐ Basement w/o plumbing

Comments / Conditions

INITIAL SITE SKETCH

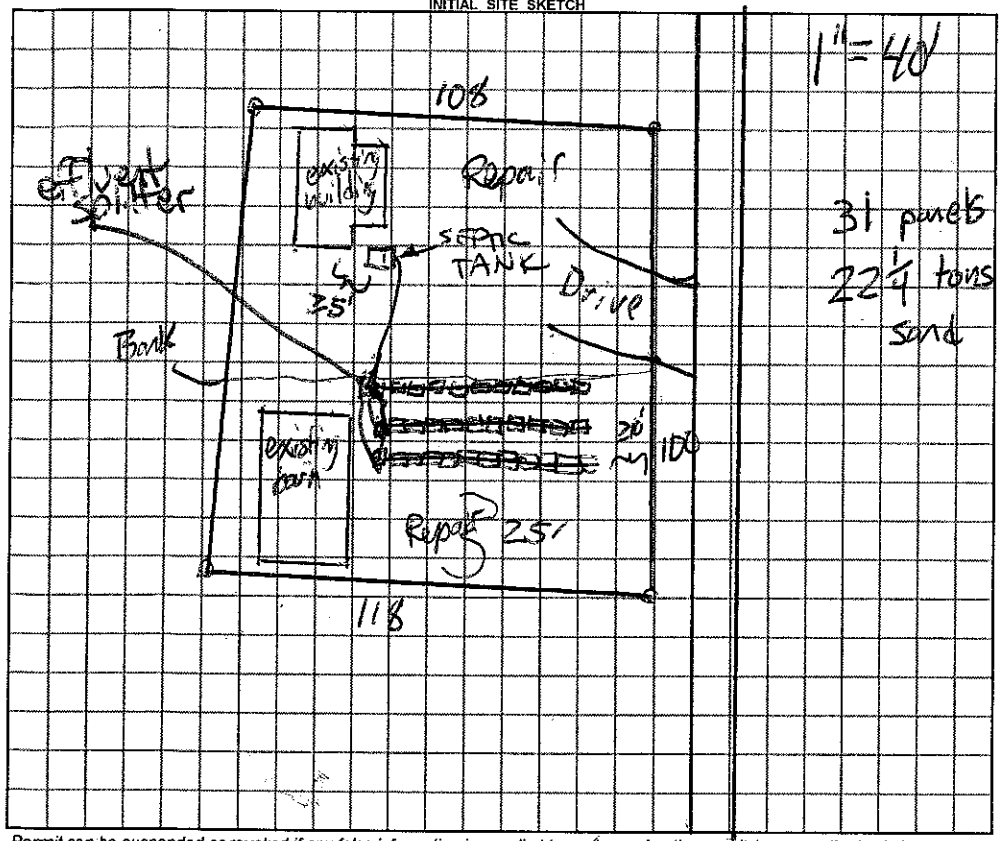

AS BUILT SKETCH

Permit can be suspended or revoked if any false information is supplied toward securing the permit / any unauthorized changes are made to the site / any unauthorized changes are made in the installation of the system.

☐ ***IMPROVEMENT PERMIT*** with plat valid without expiration. ☒ ***IMPROVEMENT PERMIT*** with plat valid ~~without expiration~~ 60 mos. ☒ ***AUTHORIZATION TO CONSTRUCT*** valid for period equal to IMPROVEMENT PERMIT--not to exceed 60 mo.

Owner / Applicant Signature: Randy L Sauls Date 2-14-11 Installed by: Madison Grading

IMPROVEMENT PERMIT by: REHS Date 2-8-11 OPERATION PERMIT by: REHS Date 2/21/11

AUTHORIZATION TO CONSTRUCT by: REHS Date 2-8-11 Existing System Inspected by: REHS Date

YOU SHOULD CONTACT A LOCATOR SERVICE PRIOR TO ANY EXCAVATION

White Copy – Environmental Health YELLOW COPY (Final) Owner / Applicant PINK COPY (Initial) Owner / Applicant