IREDELL COUNTY HEALTH DEPARTMENT

STATESVILLE 704-878-5305 (O) MOORESVILLE 704-664-5281

IMPROVEMENT PERMIT / AUTHORIZATION TO CONSTRUCT / OPERATION PERMIT / EXISTING SYSTEM INSPECTION

PERMIT# 103735 PIN# 4811-19-6515 DATE 1-30-02

OWNER OR CONTRACTOR LOVE VALLEY PUBLIC LANDS PHONE: Business 704-592-7451 Home

ADDRESS 169 HENRY MARTIN TRAIL, STATESVILLE NC 28625

LOCATION NC 115 N, TL MTN. VIEW RD, TR LOVE VALLEY ROAD CONTINUE HENRY MARTIN TRAIL, ON LEFT AT WALLACE PASS

SUBDIVISION _____ BLOCK / SECTION _____ LOT _____ LOT AREA 0.540 ACRE SITE CLASS PS DESIGN FLOW 100 L.T.A.R. 0.30 SPD/PTC

Septic Tank: 1500 Gallons; STB 338 Date 2-4-02
Pump Tank: _____ Gallons; PT _____ Date _____
Pump Make: _____ Model _____ Serial No _____
Nitrification Field: No Fields 1 Square Feet 333 Linear Feet 111
No Lines TWO Trench Width 36" Max Trench Bottom Depth 36" Gravel Depth 12"

☑ New System ☐ Repair System Type: I (II) III. IV. V. VI
System Description: CONVENTIONAL, GRAVITY
Repair System Description: MAX. FEASIBLE
Maintenance Agreement Required: ☐ Yes ☑ No CONV.
☐ Slab ☑ Crawl Space ☐ Basement w/plumbing ☐ Basement wo/plumbing

☐ House/Mod. Home No. Bedrooms _____
☐ Mobile Home No. Bathrooms 4
☑ Business No. Employees _____
☐ Other TOWN HALL & LIBRARY


Water Supply:
☐ Individual
☑ Public
☐ Community

Comments/Conditions: TWO FACILITIES ON ONE SYSTEM USING 1500 GALLON SEPTIC TANK AS SHOWN

SCALE: 1" = 40'

Comments/Conditions: SEPTIC TANK WITH RISERS AND MARKER INSTALLED USING "ZABEL" FILTER

INITIAL SITE SKETCH

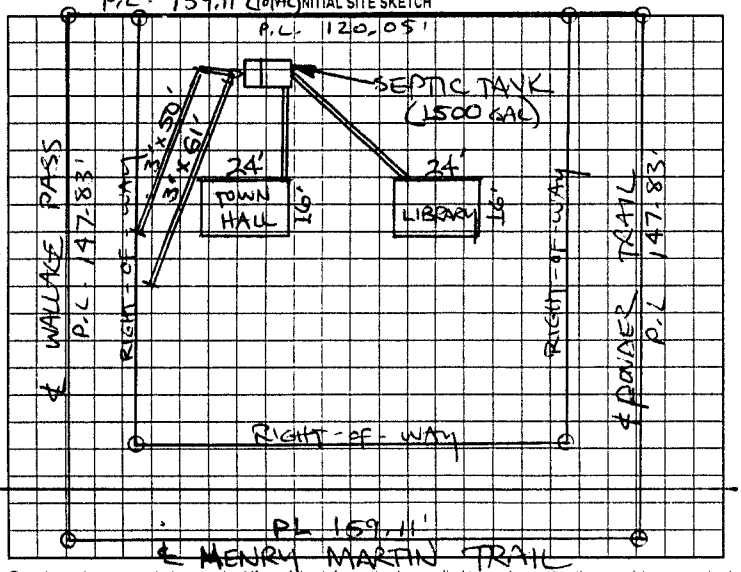

AS BUILT SKETCH

SYSTEM INSTALLED ACCORDING TO INITIAL SITE SKETCH

Permit can be suspended or revoked if any false information is supplied toward securing the permit/any unauthorized changes are made to the site/any unauthorized changes are made in the installation of the system. Improvement Permit with plat valid without expiration. Improvement Permit with site plan valid for sixty months. Authorization to Construct is valid for a period equal to that of Improvement Permit – not to exceed sixty months.

Signed: Becerra & Barker date 1-30-02 Installed by: ANDY DANIELS

Improvement Permit by: STEVE HEDRICK date 1-30-02 Operation Permit by: STEVE HEDRICK date 3-7-02

Authorization to Construct by: STEVE HEDRICK date 1-30-02 Existing System Inspection by: _____ date _____

HEALTH DEPT. COPY WHITE OWNER COPY (FINAL) YELLOW OWNER COPY (INITIAL) PINK