* Relmpvt. Replaces permit issued 24 October 08.

IREDELL COUNTY HEALTH DEPARTMENT

STATESVILLE 704-878-5305 MOORESVILLE 704-664-5281

IMPROVEMENT PERMIT / AUTHORIZATION TO CONSTRUCT / OPERATION PERMIT / EXISTING SYSTEM INSPECTION

45629 PERMIT # LOVE VALLEY PIN # 4811-19-7279 DATE 9 September 09

OWNER or APPLICANT Lonnie Allen PHONE: Business (919) 631-1632 Home: (919) 963-3776

OWNER or APPLICANT ADDRESS P.O. Box 1291 Four Oaks, N.C. 27524

LOCATION / DIRECTIONS 138 Henry Martin Trail Love Valley, I-77N - TL NW. into TR into Love Valley - on Rt.

SUBDIVISION BLOCK / SECTION LOT # LOT AREA DESIGN FLOW 194 gpd L.T.A.R. 0.2 gpd/ft²/d

Septic Tank 1000 g Gallons: STB 1000 Date 10-8-09
Pump Tank Gallons: P T Date
Pump Make Model Serial #
Nitrification Field No Fields 1 No Lines 4 Linear Feet 240'
Trench Width 36" Max. Trench Bottom Depth 36" Gravel Depth

☑ New System ☐ Repair ☐ Expansion System Type I II (III) IV V VI
System Description: 25% Reduction
Repair System Description: 50% Reduction - LPP
Maintenance Agreement Required ☐ YES ☑ NO
☑ GRAVITY ☐ PRESSURE

☐ Residence No. Bedrooms 0
☑ Business No. Persons 0
☑ Other * No. Employees 2
☐ Slab ☐ Crawl Space
☐ Basement w/plumbing ☐ Basement w/o plumbing

Water Supply: ☐ Private ☑ Public ☐ Community


Comments / Conditions * Easement Attached for repair Area

Comments / Conditions * General Store - existing building 1200 ft²

INITIAL SITE SKETCH

Please see Attached Site sketch. (Attach. #1)

AS BUILT SKETCH

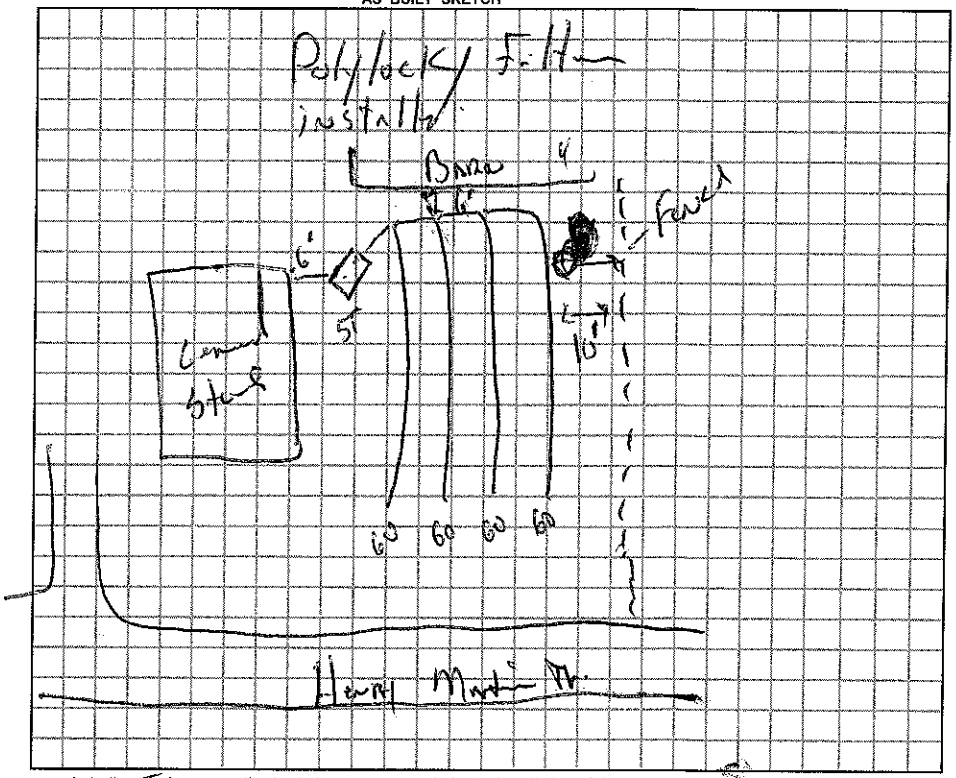

Permit can be suspended or revoked if any false information is supplied toward securing the permit / any unauthorized changes are made to the site / any unauthorized changes are made in the installation of the system.

☐ *IMPROVEMENT PERMIT w / plat valid without expiration.* ☑ *IMPROVEMENT PERMIT w / site plan valid for 60 mos.* ☑ *AUTHORIZATION TO CONSTRUCT valid for period equal to IMPROVEMENT PERMIT-not to exceed 60 mo.*

Owner / Applicant Signature: Date 11-13-09 Installed by: Mark J. Daniels

Improvement Permit by: R.S. Date 9 September 09 Operation Permit by: R.S. Date: 13 Jan. 2010

Authorzation to Construct by: R.S. Date 9 September 09 Existing System Inspected by: Date:

YOU SHOULD CONTACT A LOCATOR SERVICE PRIOR TO ANY EXCAVATION.

WHITE COPY Environmental Health YELLOW COPY (Final) Owner / Applicant PINK COPY (Initial) Owner / Applicant