47316

IREDELL COUNTY HEALTH DEPARTMENT

STATESVILLE 704-878-5305 MOORESVILLE 704-664-5281

IMPROVEMENT PERMIT / CERTIFICATE OF COMPLETION / OPERATION PERMIT / EXISTING SYSTEM INSPECTION

TAX MAP NO. 150-A-37 / 72

PROPERTY DESCRIPTION NO. 16395 DATE 6-2-93 PHONE: Business 263-0830 Home

OWNER OR CONTRACTOR Donald Smith

ADDRESS

LOCATION Hwy 115N TR Mt View Rd. TR Love Valley Rd. Lot on R behing building on R. once in town.

SUBDIVISION BLOCK / SECTION LOT LOT AREA SITE CLASS. L.T.A.R.

Water Supply: ☑ Individual ☐ Community ☐ Public Well to be located.

Septic Tank: 1000 Gallons; STB 5-29-93 Date 1012

Pump Tank: — Gallons; PT — Date —

Nitrification Field: No Fields 1 Square Feet 600 Linear Feet 200'

No Lines 2 Trench Width 36" Trench Depth 36" Gravel Depth 12"

☑ New System ☐ Repair System Type: I. II. III. IV. V. VI

System Description: Conventional, gravity

Repair System Description: "

Maintenance Agreement Required: ☐ Yes ☑ No

☑ House/Mod. Home ☐ Mobile Home ☐ Business ☐ Other

No. Bedrooms 1 No. Bathrooms 1 No. Employees —

☐ Slab ☑ Crawl Space ☐ Basement w/plumbing ☐ Basement wo/plumbing

Garbage Disposal: ☐ Yes ☑ No


Auto. Dishwasher: ☐ Yes ☑ No

Auto. Washing Machine: ☑ Yes ☐ No

Other

Comments Keep well min. 50' from any part of septic system.
100% Repair, conventional, gravity fed.

INITIAL SITE SKETCH

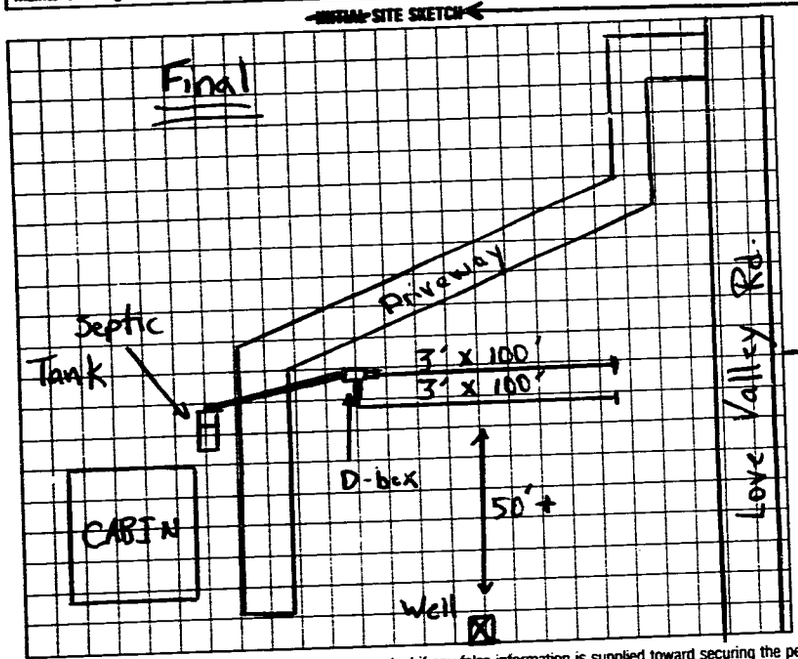

AS BUILT SKETCH

I understand that this permit can be suspended or revoked if any false information is supplied toward securing the permit/any unauthorized changes are made to the site/any unauthorized changes are made in the installation of the system. Improvement Permit is valid for 60 months from date of issuance.

Signed:

Improvement Permit by: Steve Hedrick date 5-29-93

Existing System Inspection by: date

Installed by: Pearson's Grading.

Certificate of Completion by: Michael L Dennard date 6-2-93

Operation Permit by: date

HEALTH DEPT. COPY: WHITE INSPECTION COPY (FINAL): GREEN OWNER COPY (FINAL): YELLOW INSPECTION COPY (INITIAL): PINK OWNER COPY (INITIAL): GOLD