IREDELL COUNTY HEALTH DEPARTMENT

STATESVILLE 704-878-5305 MOORESVILLE 704-664-5281

IMPROVEMENT PERMIT / AUTHORIZATION TO CONSTRUCT / OPERATION PERMIT / EXISTING SYSTEM INSPECTION

PERMIT# 088400 PIN# 4811 30 5790 (PT) DATE 4-10-00

OWNER OR CONTRACTOR BRAD BUNTON PHONE: Business ______ Home 876-1670

ADDRESS 132 BUNTON LANE, STATESVILLE, NC 28625

LOCATION NC 115 N, TL MTN. VIEW RD, TL BUNTON LANE, BEAR RIGHT TO END

SUBDIVISION ______ BLOCK / SECTION ______ LOT ______ LOT AREA 4.0 ACRES SITE CLASS PS DESIGN FLOW 360 L.T.A.R. 0.25 GAD/FT2

Septic Tank: 1000 Gallons; STB 1007 Date 7-26-00
Pump Tank: ______ Gallons; PT ______ Date ______
Pump Make: ______ Model ______ Serial No. ______
Nitrification Field: No Fields 1 Square Feet EQ TO 1440 Linear Feet 360'
No Lines SIX Trench Width 36" Max Trench Bottom Depth 32" ~~Gravel~~ Depth SAND 6"

☑ New System ☐ Repair System Type: I II (III) IV V VI
System Description: 25% REDUCTION GRAVITY
Repair System Description: LOW PRESSURE PIPE
Maintenance Agreement Required: ☐ Yes ☑ No
☐ Slab ☑ Crawl Space ☐ Basement w/plumbing ☐ Basement wo/plumbing


☑ House/Mod. Home No. Bedrooms 3
☐ Mobile Home No. Bathrooms 2
☐ Business No. Employees ______
☐ Other ______

Water Supply: ☑ Individual ☐ Public ☐ Community — WELL

Comments:/Conditions: ① INSTALL 25% REDUCTION GRAVITY SYSTEM USING SIXTY (60) CHAMBERS OR THIRTY-SIX (36) HDS SECTIONS ON CONTOUR AS SHOWN ② KEEP SYSTEM MINIMUM 100 FEET FROM WELL

Comments:/Conditions: SEPTIC TANK W/ MARKER INSTALLED USING "POLYLOK" FILTER

INITIAL SITE SKETCH

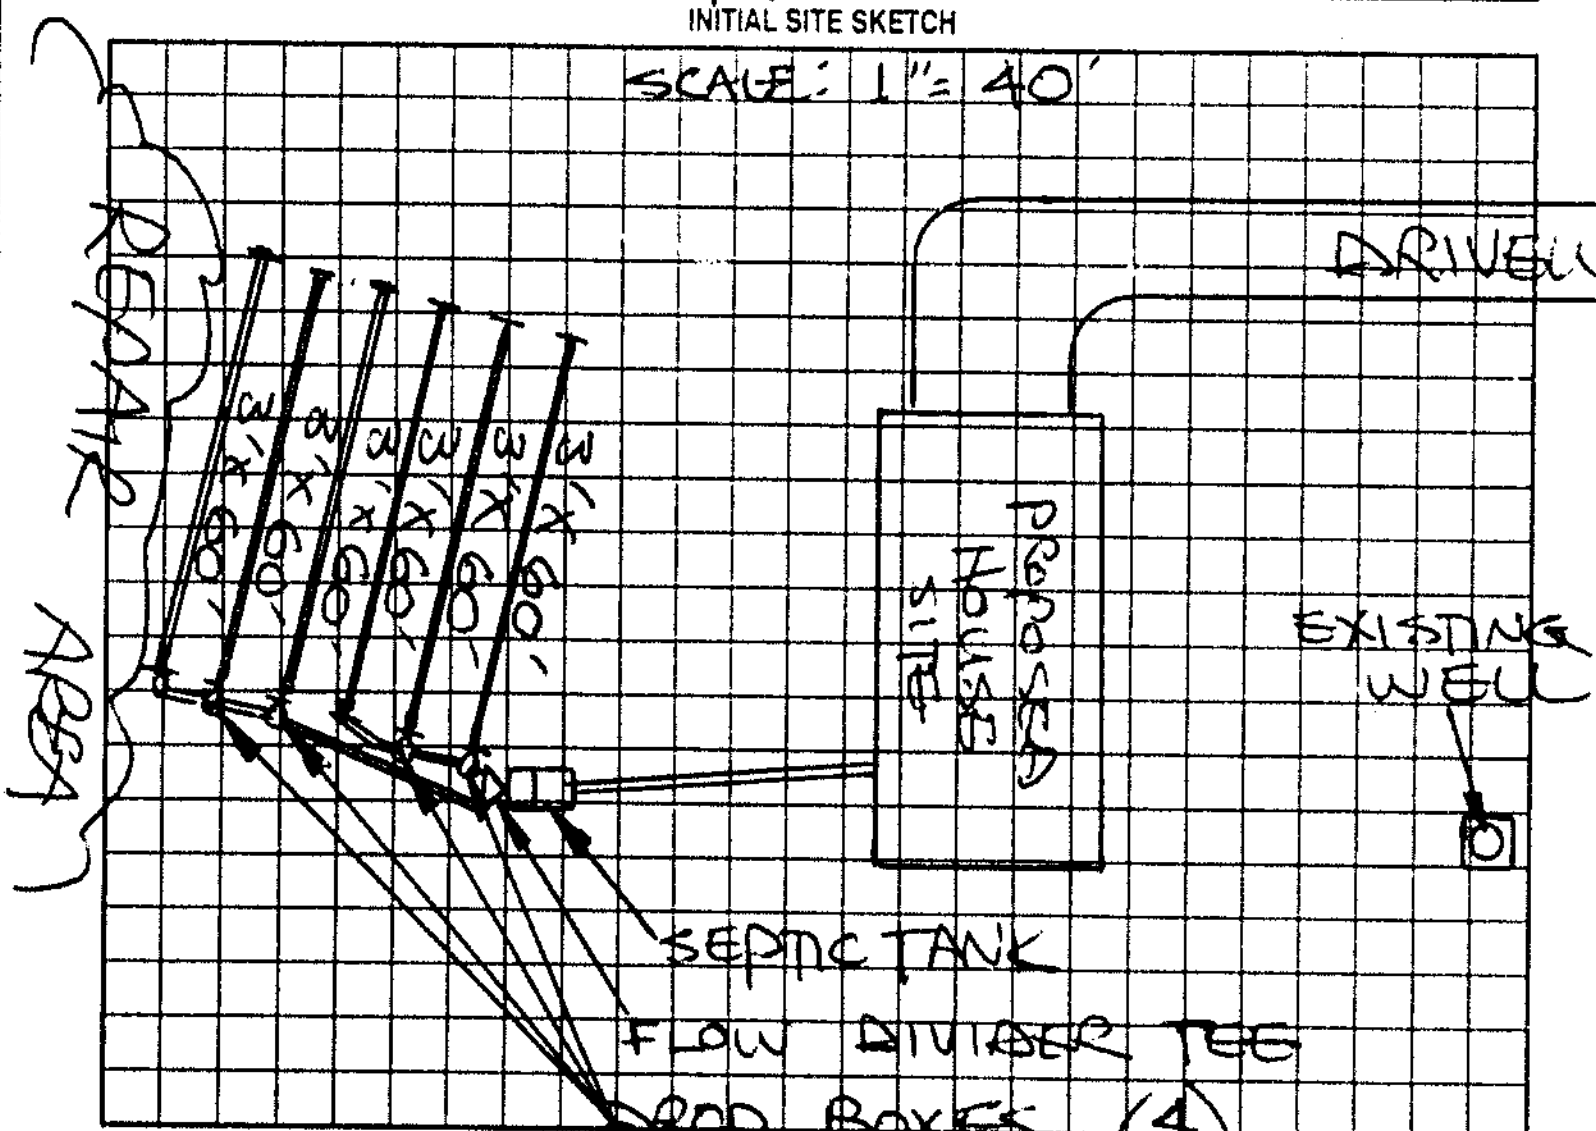

AS BUILT SKETCH

SYSTEM INSTALLED ACCORDING TO INITIAL SITE SKETCH

Permit can be suspended or revoked if any false information is supplied toward securing the permit/any unauthorized changes are made to the site/any unauthorized changes are made in the installation of the system. Improvement Permit with plat valid without expiration. Improvement Permit with site plan valid for sixty months. Authorization to Construct is valid for a period equal to that of Improvement Permit – not to exceed sixty months.

Signed: [signature] date 4/28/00 Installed by: JAMES HUDLER

Improvement Permit by: STEVE HEDRICK date 4-10-00 Operation Permit by: STEVE HEDRICK date 8-30-00

Authorization to Construct by: STEVE HEDRICK date 4-10-00 Existing System Inspection by: ______ date ______

HEALTH DEPT COPY WHITE OWNER COPY (FINAL) YELLOW OWNER COPY (INITIAL) PINK