IREDELL COUNTY HEALTH DEPARTMENT

STATESVILLE 704-878-5305 (CI) MOORESVILLE 704-664-5281

IMPROVEMENT PERMIT / AUTHORIZATION TO CONSTRUCT / OPERATION PERMIT / EXISTING SYSTEM INSPECTION

PERMIT# 110158 PIN# 4811-35-3246 DATE 1-17-03

OWNER OR CONTRACTOR EDWARD SHUMAKER, BUILDER PHONE: Business (704) 592-5813 Home (704) 592-5814

ADDRESS 623 BROOKHAVEN ROAD, STATESVILLE, NC 28625

LOCATION NC 115 N, TL BROOKHAVEN ROAD, 1ST DRIVE ON LEFT PAST JUNE ROAD, BACK OFF ROAD AT BOX #623

SUBDIVISION _____ BLOCK / SECTION _____ LOT _____ LOT AREA 4 ACRES SITE CLASS. PS DESIGN FLOW 360 L.T.A.R. 0.25 GPD/FT²

Septic Tank: 1000 Gallons; STB 794 Date 9-15-03
Pump Tank: _____ Gallons; PT _____ Date _____
Pump Make: _____ Model _____ Serial No. _____
Nitrification Field: No Fields 1 Square Feet 1440 Linear Feet 480
No Lines FOUR Trench Width 36" Max Trench Bottom Depth 36" Gravel Depth 12"

☑ New System ☐ Repair System Type: I, (II), III, IV, V, VI
System Description: CONVENTIONAL, GRAVITY
Repair System Description: CONVENTIONAL, PUMP
Maintenance Agreement Required: ☐ Yes ☑ No


☑ House/Mod. Home ☐ Mobile Home ☐ Business ☐ Other
No. Bedrooms 3 No. Bathrooms 2 No. Employees ____
☐ Slab ☐ Crawl Space ☑ Basement w/plumbing ☐ Basement wo/plumbing

Water Supply: ☑ Individual ☐ Public ☐ Community
WELL

Comments/Conditions: ① INSTALL SUBSURFACE INTERCEPT DRAINAGE DITCH AT LOCATION SHOWN BEGINNING 48" DEEP, AROUND SYSTEM, THEN OUT TO DAYLIGHT. ② EXISTING S/W MH TO BE REMOVED UPON OCCUPANCY OF HOUSE.

Comments/Conditions: ZABEL FILTER & MARKER
V'D LINES ON 10-31-03. ITS OK NEEDS TO ROOF SUB. INT. DRAIN. H2O RISE ON IT. LL

INITIAL SITE SKETCH

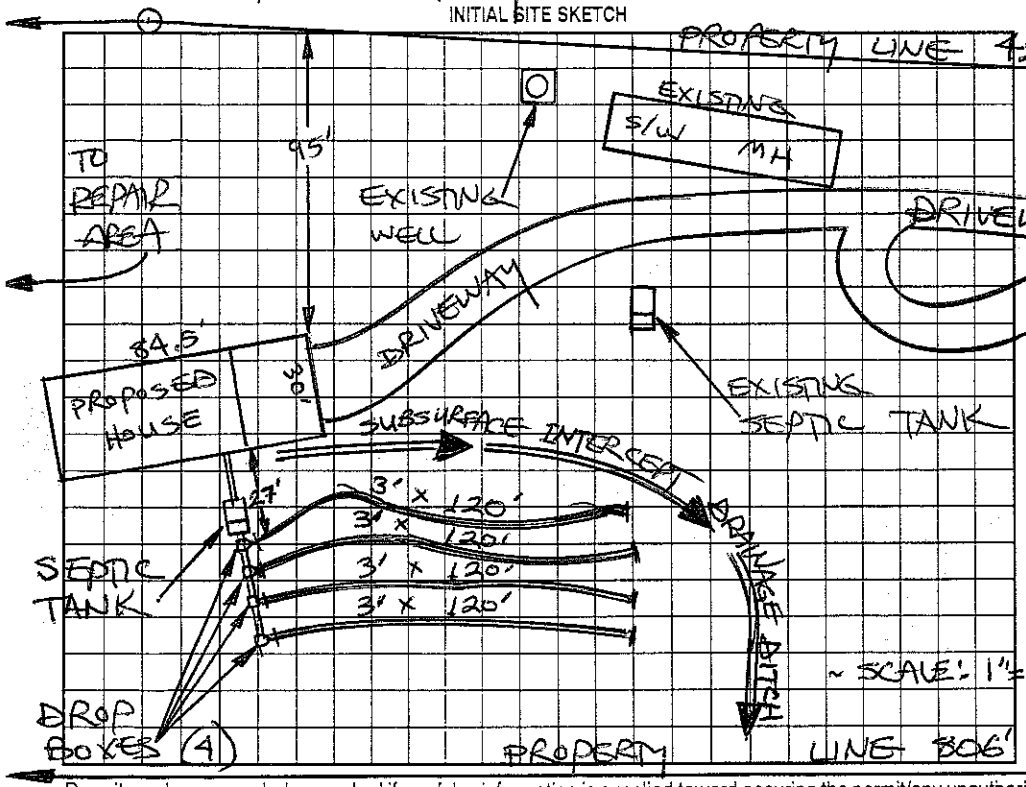

AS BUILT SKETCH

SYSTEM INSTALLED ACCORDING TO INITAL SITE SKETCH

Permit can be suspended or revoked if any false information is supplied toward securing the permit/any unauthorized changes are made to the site/any unauthorized changes are made in the installation of the system. Improvement Permit with plat valid without expiration. Improvement Permit with site plan valid for sixty months. Authorization to Construct is valid for a period equal to that of Improvement Permit – not to exceed sixty months.

Signed: Edward Shumaker date _____ Installed by: MADISON GRADING

Improvement Permit by: STEVE HEDRICK date 1-17-03 Operation Permit by: STEVE HEDRICK date 11-3-03

Authorization to Construct by: STEVE HEDRICK date 1-17-03 Existing System Inspection by: _____ date _____

HEALTH DEPT. COPY: WHITE OWNER COPY (FINAL): YELLOW OWNER COPY (INITIAL): PINK