IREDELL COUNTY HEALTH DEPARTMENT

Statesville Office (704) 878-5305 Mooresville Office (704) 660-3625 PERMIT # 216744

IMPROVEMENT PERMIT / AUTHORIZATION TO CONSTRUCT / OPERATION PERMIT / EXISTING SYSTEM

PIN # 4811-44-4495.000 43-1969

APPLICANT: Bobby Anderson APPLICANT ADDRESS: 239 Kinder Rd. Harmony NC 28634

SITE ADDRESS: 248 Myrtle Rd. Statesville NC 28625 PHONE: 704-880-3924 ALT. PHONE: 704-546-2273

SITE DIRECTIONS: Hwy 115 N, TL on Mountain View Rd. TR Myrtle Rd., Site on R

SUBDIVISION: — SECTION: — LOT # — LOT AREA: 44.022 Acre DESIGN FLOW: Existing L.T.A.R.: Existing

Septic Tank Existing (gal) STB Date

Pump Tank (gal) PT Date

Pump Make Model Serial #

Nitrification Fields Ex. # Lines Ex Linear Ft: Ex

Trench Width Ex Max. Trench Bottom Depth Ex Gravel Depth Ex

☐ New System ☐ Repair ☐ Expansion System Type: I (II) III IV V VI

System Description: Existing Conventional - Gravity

Repair System Description: Conventional - Gravity

Maintenance Agreement Required: ☐ YES ☒ NO

☒ GRAVITY ☐ PRESSURE

☒ Residence No. Bedrooms Ex.

☐ Business No. Persons Ex.

☐ Other No. Employees

☐ Slab ☒ Crawl Space


☐ Basement w/plumbing ☐ Basement w/o plumbing

Water Supply: ☒ Private ☐ Public ☐ Community


Comments / Conditions: Existing System Assumed To Be Functioning @ Time of Inspection. This Permit is For Permitting of Proposed 75'x50' Shop.

INITIAL SITE SKETCH

1" = 60'

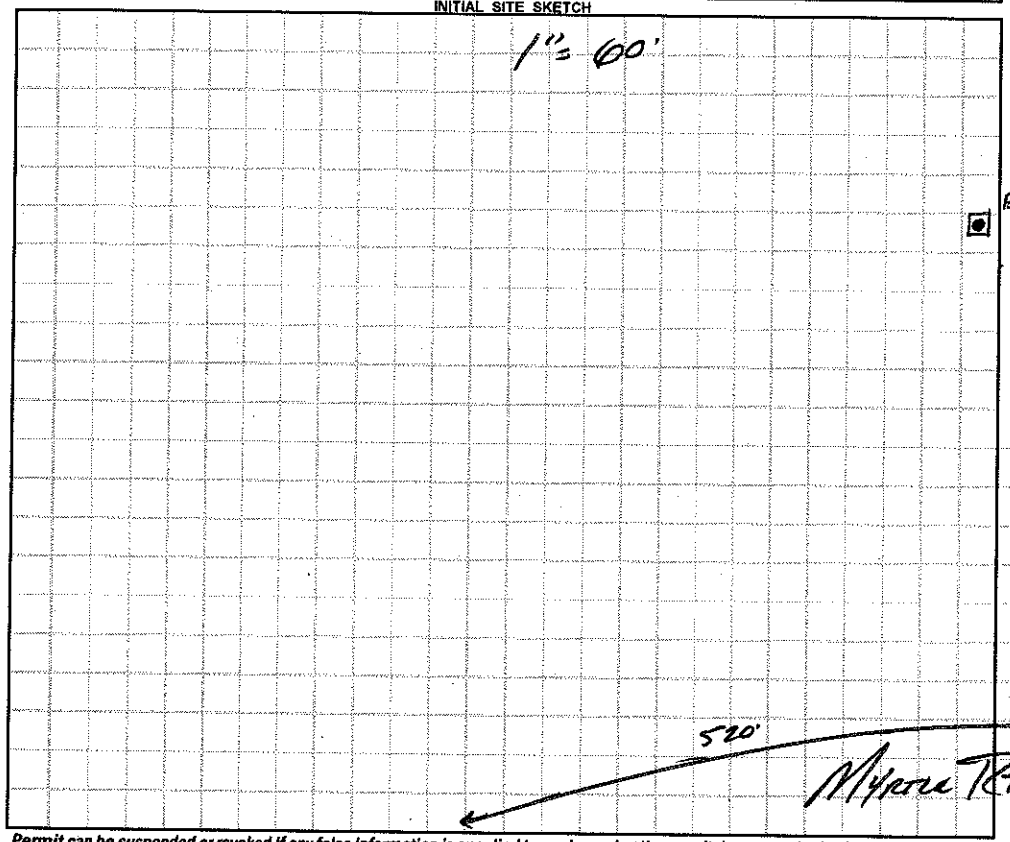

EXISTING AS BUILT SKETCH

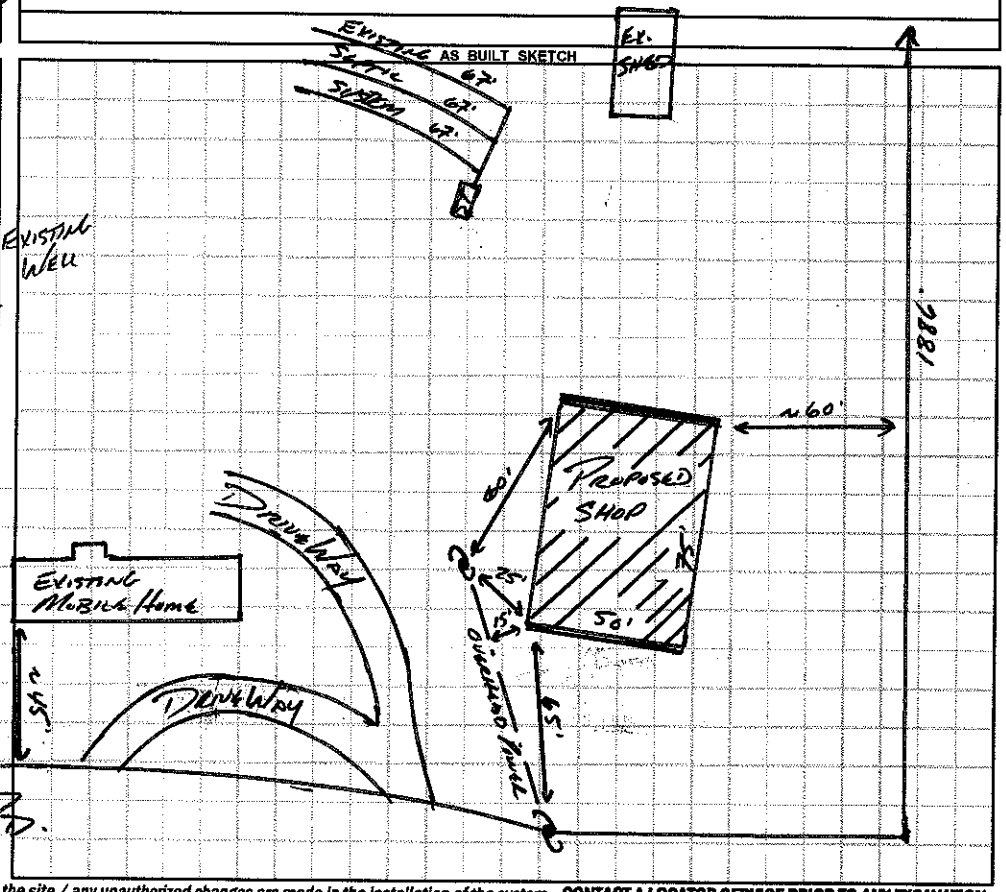

Permit can be suspended or revoked if any false information is supplied toward securing the permit / any unauthorized changes are made to the site / any unauthorized changes are made in the installation of the system. **CONTACT A LOCATOR SERVICE PRIOR TO ANY EXCAVATION**

☐ **IMPROVEMENT PERMIT** *with plat valid without expiration.* ☐ **IMPROVEMENT PERMIT** *with site plan valid for 60 mos.* ☐ **AUTHORIZATION TO CONSTRUCT** *valid for period equal to IMPROVEMENT PERMIT--not to exceed 60 mo.*

Owner / Applicant Signature: Bobby Anderson Date: 3-30-16 Installed by:

IMPROVEMENT PERMIT by: Date: OPERATION PERMIT by: Date:

AUTHORIZATION TO CONSTRUCT by: Date: Existing System Inspected by: Date: APPROVED MAR 27 2016

Health Dept. Copy - WHITE Applicant (Final Approval) - YELLOW Applicant (Conditional Approval) - PINK