# IREDELL COUNTY HEALTH DEPARTMENT

STATESVILLE 704-878-5305 MOORESVILLE 704-664-5281

## IMPROVEMENT PERMIT / AUTHORIZATION TO CONSTRUCT / OPERATION PERMIT / EXISTING SYSTEM INSPECTION

PERMIT# 074527 PIN# 4811 50 6606 DATE 6-24-98

OWNER OR CONTRACTOR THOMAS KARRENSTEIN PHONE: Business Home 876-3848

ADDRESS 472 MOUNTAIN VIEW ROAD, STATESVILLE, NC. 28625

LOCATION NC115 N, TL MOUNTAIN VIEW ROAD, 1.5 MILES ON RIGHT AT BOX #472

SUBDIVISION BLOCK / SECTION LOT LOT AREA 4.1 ACRES SITE CLASS. PS DESIGN FLOW 480 L.T.A.R. 0.30 GPD/FT²

Septic Tank: 1000 Gallons; STB 625 Date 2-19-99
Pump Tank: Gallons; PT Date
Pump Make: Model Serial No.
Nitrification Field: No Fields 1 Square Feet 1600 Linear Feet 533
No Lines FOUR Trench Width 36" Max Trench Bottom Depth 36" Gravel Depth 12"

☑ New System ☐ Repair System Type: I ☐ II, III, IV, V, VI
System Description: CONVENTIONAL GRAVITY
Repair System Description: CONV. PUMP/GRAVITY
Maintenance Agreement Required: ☐ Yes ☑ No

☑ House/Mod. Home No. Bedrooms 4
☐ Mobile Home No. Bathrooms
☐ Business No. Employees
☐ Other 4 BEDROOMS ONLY


☐ Slab ☑ Crawl Space ☐ Basement w/plumbing ☐ Basement wo/plumbing

Water Supply: ☑ Individual ☐ Public ☐ Community WELL


Comments:/Conditions: STUB-OUT PLUMBING AT SHALLOW GRADE TO KEEP SYSTEM NO DEEPER THAN 36"

Comments:/Conditions: SEPTIC TANK W/ RISERS INSTALLED WITH "ZABEL" FILTER
UPPER TWO LINES INSPECTED 3-12-99

INITIAL SITE SKETCH

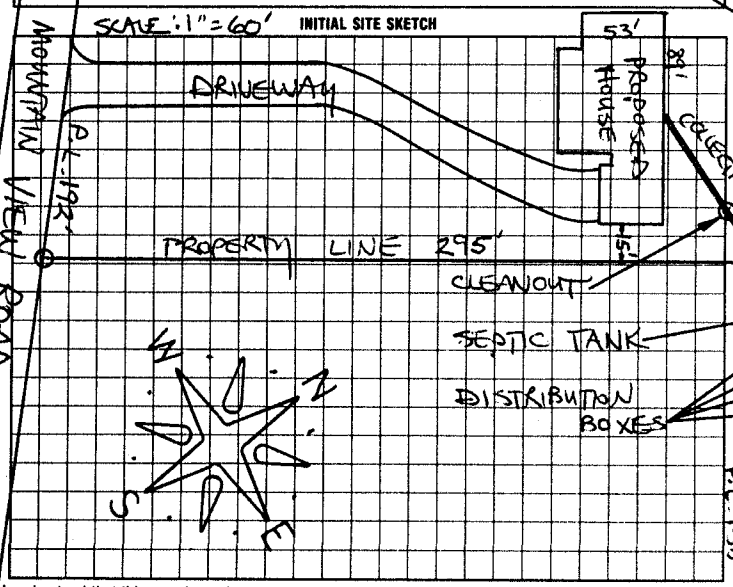


AS BUILT SKETCH

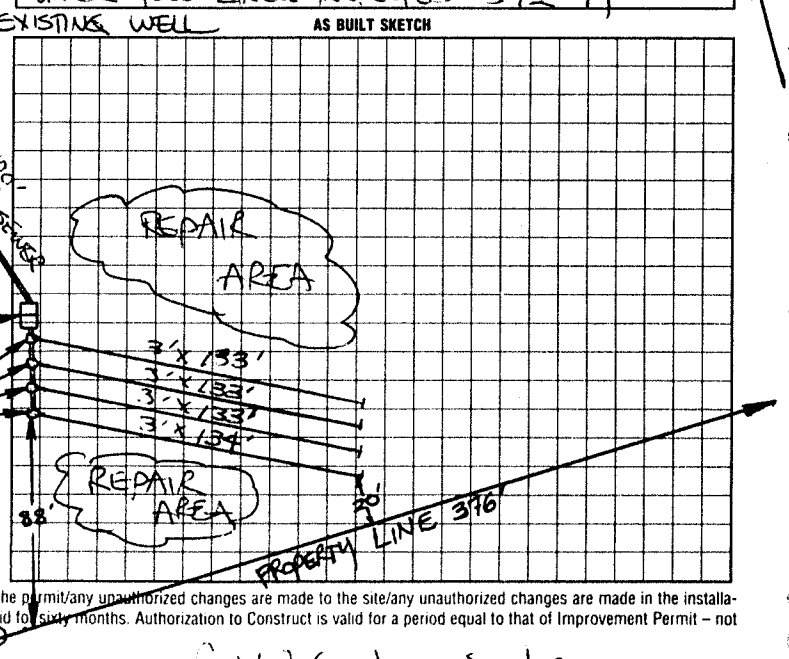


I understand that this permit can be suspended or revoked if any false information is supplied toward securing the permit/any unauthorized changes are made to the site/any unauthorized changes are made in the installation of the system. Improvement Permit with plat valid without expiration. Improvement Permit with site plan valid for sixty months. Authorization to Construct is valid for a period equal to that of Improvement Permit – not to exceed sixty months.

Signed: Tammy Karrenstein date

Improvement Permit by: STEVE HEDRICK date 6-24-98

Authorization to Construct by: STEVE HEDRICK date 6-24-98

Installed by: C&W Grading + Septic

Operation Permit by: [illegible] date 3-16-99

Existing System Inspection by: date

HEALTH DEPT. COPY: WHITE INSPECTION COPY (FINAL): GREEN OWNER COPY (FINAL): YELLOW INSPECTION COPY (INITIAL): PINK OWNER COPY (INITIAL): GOLD