IREDELL COUNTY HEALTH DEPARTMENT

STATESVILLE 704-878-5305 MOORESVILLE 704-664-5281

IMPROVEMENT PERMIT / AUTHORIZATION TO CONSTRUCT / OPERATION PERMIT / EXISTING SYSTEM INSPECTION

PERMIT# 095094 PIN# 4811 55 1966 DATE 3-27-01

OWNER OR CONTRACTOR DEBORAH CLARK PHONE: Business Home (603) 826-5132

ADDRESS 37 EGYPT ROAD, CHARLESTOWN, NH 03603

LOCATION NC 115 N, TL BROOKHAVEN ROAD, TL McGREGOR LANE, 2ND LOT ON LEFT

SUBDIVISION BLOCK / SECTION LOT 12 LOT AREA 2.78 ACRES SITE CLASS PS DESIGN FLOW 240 L.T.A.R. 0.25 GPD/FT²

Septic Tank: 1000 Gallons; STB 1012 Date 12-22-00
Pump Tank: Gallons; PT Date
Pump Make: Model Serial No.
Nitrification Field: No Fields 1 Square Feet 960 Linear Feet 320
No Lines FOUR Trench Width 36" Max Trench Bottom Depth 36" Gravel Depth 12"

☒ New System ☐ Repair System Type: I (II) III IV V VI
System Description: CONVENTIONAL GRAVITY
Repair System Description: 25% REDUCTION GRAVITY
Maintenance Agreement Required: ☐ Yes ☒ No
☐ Slab ☒ Crawl Space ☐ Basement w/plumbing ☐ Basement wo/plumbing


☒ House/Mod. Home No. Bedrooms 2
☐ Mobile Home No. Bathrooms 2
☐ Business No. Employees
☐ Other

Water Supply: ☒ Individual ☐ Public ☐ Community WELL


Comments/Conditions: ① KEEP SYSTEM MINIMUM 100' FROM WELL ② INSTALL SUBSURFACE INTERCEPT DRAINAGE DITCH AT LOCATION SHOWN BEGINNING 48" DEEP OUT TO DAYLIGHT

Comments/Conditions: SEPTIC TANK WITH MARKER INSTALLED USING "POLYLOK" FITTER

INITIAL SITE SKETCH

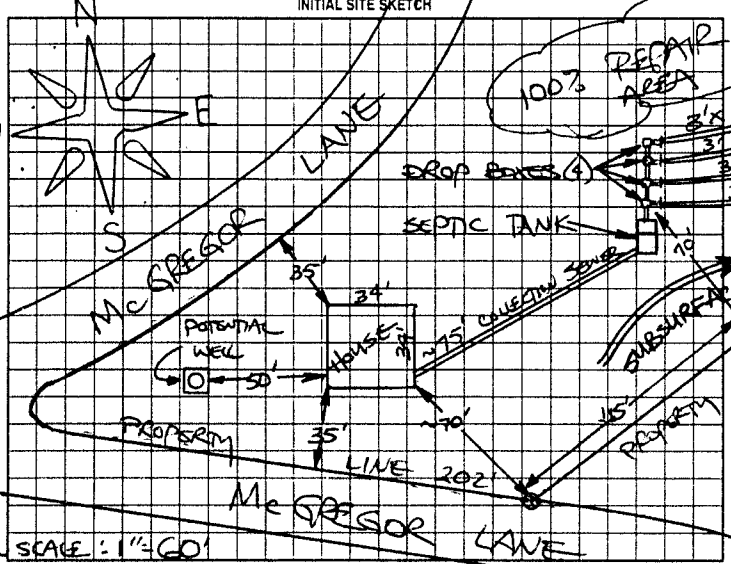

AS BUILT SKETCH

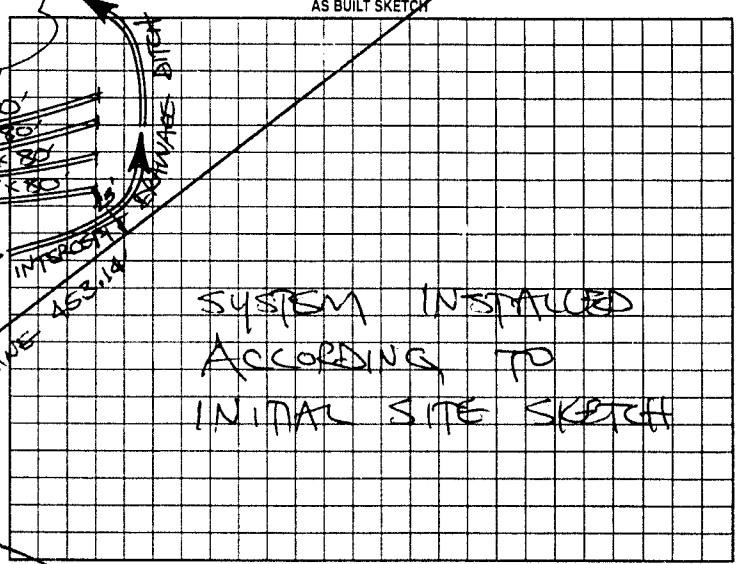

Permit can be suspended or revoked if any false information is supplied toward securing the permit/any unauthorized changes are made to the site/any unauthorized changes are made in the installation of the system. Improvement Permit with plat valid without expiration. Improvement Permit with site plan valid for sixty months. Authorization to Construct is valid for a period equal to that of Improvement Permit – not to exceed sixty months.

Signed: + Deborah Clark date 3-27-01 Installed by: STEVE JORDAN

Improvement Permit by: STEVE HEDRICK date 3-27-01 Operation Permit by: STEVE HEDRICK date 5-11-01

Authorization to Construct by: STEVE HEDRICK date 3-27-01 Existing System Inspection by: date

HEALTH DEPT. COPY: WHITE OWNER COPY (FINAL) YELLOW OWNER COPY (INITIAL) PINK