IREDELL COUNTY HEALTH DEPARTMENT

Statesville Office (704) 878-5305 Mooresville Office (704) 660-3625 PERMIT # 208829

IMPROVEMENT PERMIT / AUTHORIZATION TO CONSTRUCT / OPERATION PERMIT / EXISTING SYSTEM

PIN # 4811551966

APPLICANT: Richard Monteith APPLICANT ADDRESS: 153 McGregor Ln.

SITE ADDRESS: 153 McGregor Ln. PHONE: 704-592-2319 ALT. PHONE: N/A

SITE DIRECTIONS: Hwy 115N TL Mountain View Rd TL McGregor Ln.


SUBDIVISION: Grier Bros SECTION: N/A LOT # TR 12 LOT AREA: 2.178 acres DESIGN FLOW: 240gpd L.T.A.R.: Existing

Septic Tank	Existing (gal)	STB		Date		☐ New System	☐ Repair	☐ Expansion	System Type: I (II) III IV V VI	☑ Residence	No. Bedrooms	2	Water Supply		
Pump Tank	(gal)	PT		Date		System Description:			Conventional	☐ Business	No. Persons		☑ Private		
Pump Make		Model		Serial #		Repair System Description:				☐ Other	No. Employees		☐ Public		
# Nitrification Fields	1	# Lines	4	Linear Ft:	Ex	Maintenance Agreement Required:	☐ YES	☑ NO		☐ Slab	☑ Crawl Space		☐ Community		
Trench Width	Ex	Max. Trench Bottom Depth	Ex	Gravel Depth	Ex		☑ GRAVITY	☐ PRESSURE		☐ Basement w/plumbing		☐ Basement w/o plumbing			


Comments / Conditions:

- Maintain a minimum of 5' between Proposed addition foundation & all components of septic system.

INITIAL SITE SKETCH

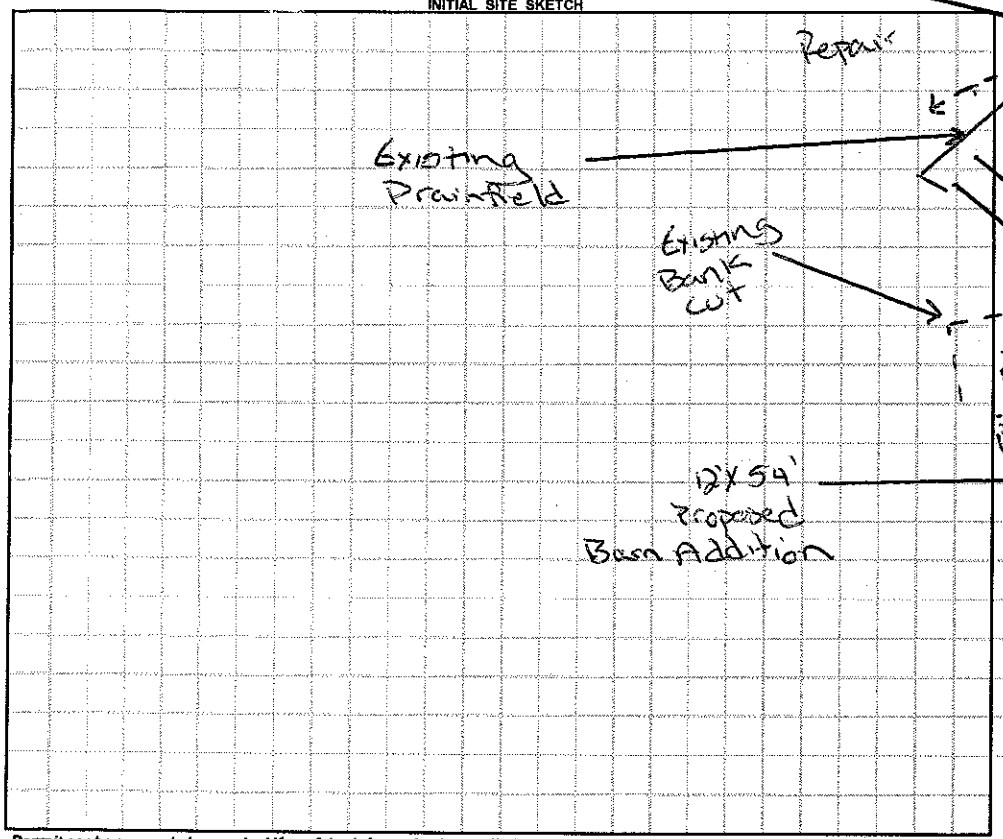

AS BUILT SKETCH

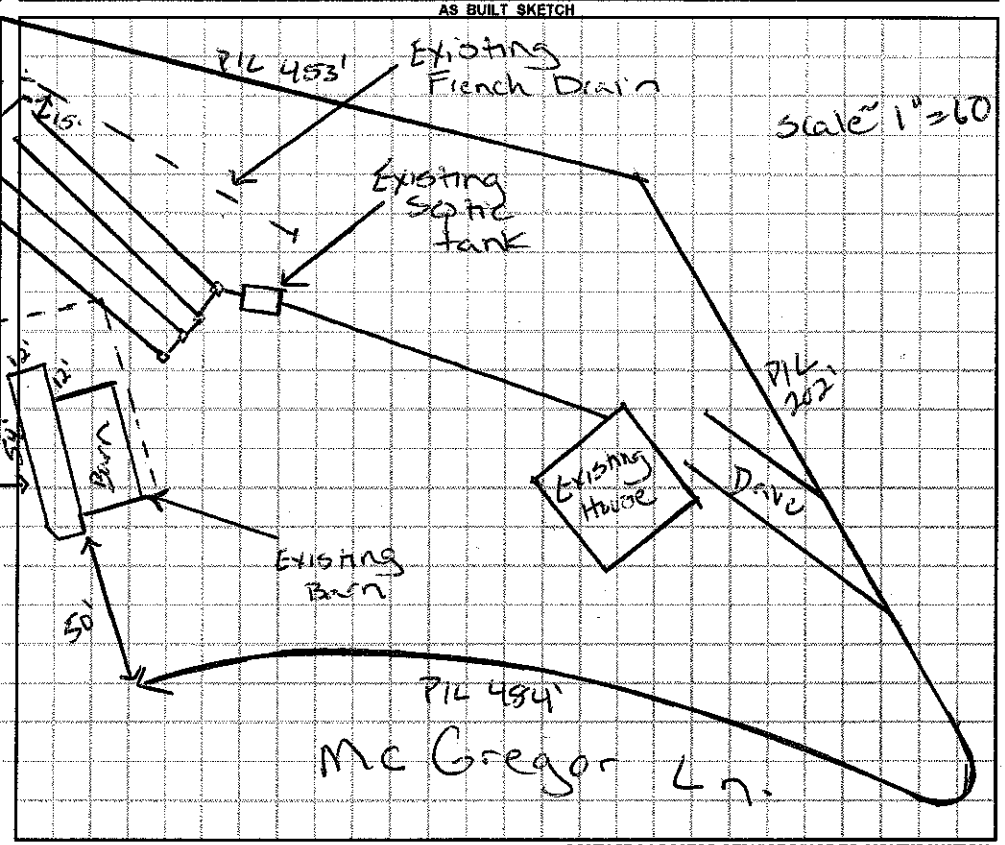

Permit can be suspended or revoked if any false information is supplied toward securing the permit / any unauthorized changes are made to the site / any unauthorized changes are made in the installation of the system. **CONTACT A LOCATOR SERVICE PRIOR TO ANY EXCAVATION**

☐ **IMPROVEMENT PERMIT** *with plat valid without expiration.* ☐ **IMPROVEMENT PERMIT** *with site plan valid for 60 mos.* ☐ **AUTHORIZATION TO CONSTRUCT** *valid for period equal to IMPROVEMENT PERMIT--not to exceed 60 mo.*

Owner / Applicant Signature: [signature] Date: 3-18-15 Installed by:

IMPROVEMENT PERMIT by: Date: OPERATION PERMIT by: Date:

AUTHORIZATION TO CONSTRUCT by: Date: Existing System Inspected by: Justin Henderson Date: 3-17-15

Health Dept. Copy - WHITE Applicant (Final Approval) - YELLOW Applicant (Conditional Approval) - PINK