KW

IREDELL COUNTY HEALTH DEPARTMENT

Statesville Office (704) 878-5305 Mooresville Office (704) 660-3625 PERMIT # 239902

SEPTIC IMPROVEMENT PERMIT / AUTHORIZATION TO CONSTRUCT / OPERATION PERMIT / EXISTING SYSTEM

PIN # 4811570752.538

APPLICANT/OWNER: Michael May Rash APPLICANT ADDRESS: 536 Brookhaven Rd

SITE ADDRESS: 538 Brookhaven Rd; Statesville 28625 PHONE: 704 592-2791 ALT. PHONE

SITE DIRECTIONS: Hwy 115 N to Brookhaven Rd L go 2 miles to Otter Farm on Rd SAP CONTROLLED: [X] YES [ ] NO

SUBDIVISION: - SECTION: - LOT # - LOT AREA: 26.43 DESIGN FLOW: 240 gpd L.T.A.R.: .275


Septic Tank	1000	(gal)	STB	854	Date	5-23-19	[X] New System	[ ] Repair	[ ] Expansion	System Type: I II [III] IV V VI	
Pump Tank	-	(gal)	PT	-	Date	-	System Description:	25% Reduction			
Pump Make	-	Model	-		Serial #	-	Repair System Description:	25% Reduction			
# Nitrification Fields	1	# Lines	3		Linear Ft	218	Maintenance Agreement Required:	[ ] YES	[X] NO		
Trench Width	36"	Trench Bottom Depth(Low side)	32" Max		Gravel Depth	-		[X] GRAVITY	[ ] PRESSURE		

[X] Residence No. Bedrooms 2 [ ] Business No. Persons 4 [ ] Other No. Employees [ ] Slab [X] Crawl Space [ ] Basement w/plumbing [ ] Basement w/o plumbing


Water Supply: [X] Private [ ] Public [ ] Community

Comments / Conditions: Install Drawings on Center of land and use Serial distribution. Do not park, grade or bury utilities in septic area. 240' to 2 outlets 218 Required

INITIAL SITE SKETCH

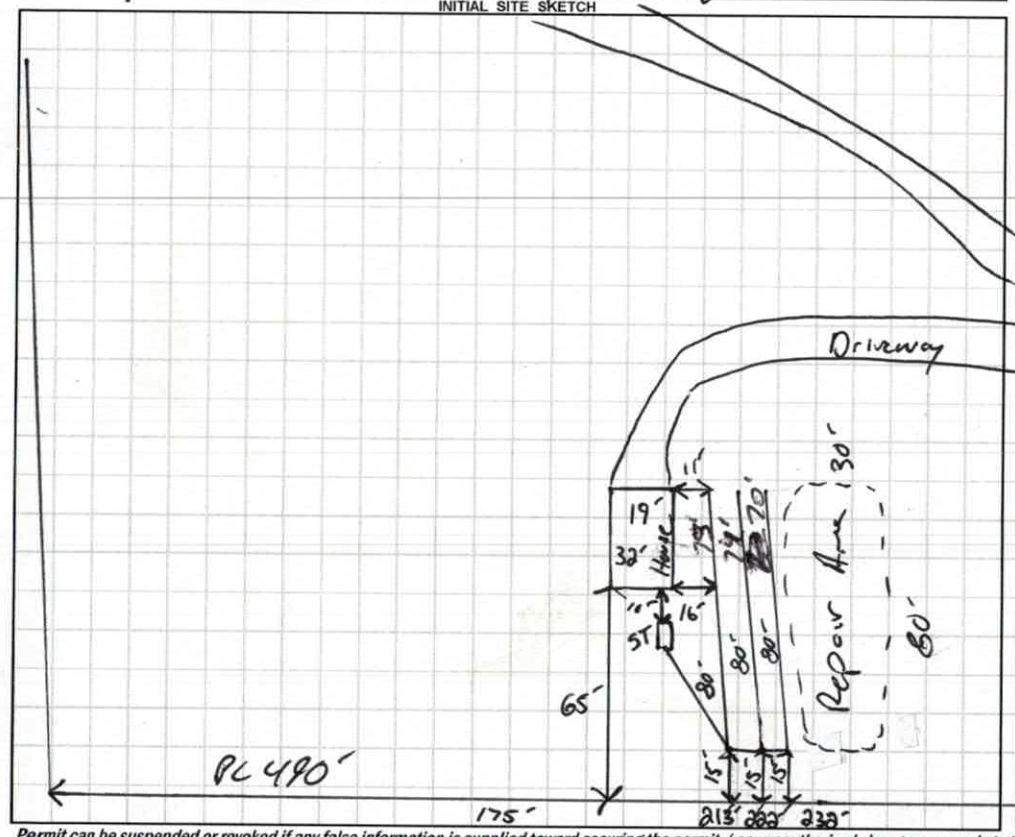

AS BUILT SKETCH

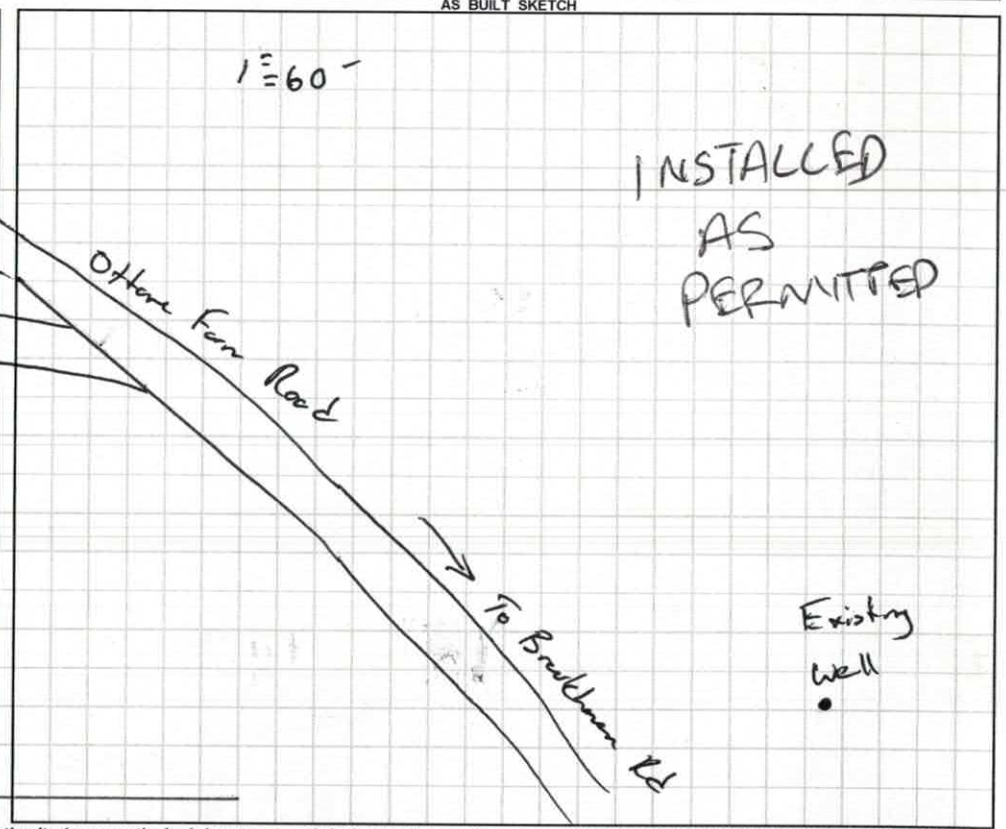

Permit can be suspended or revoked if any false information is supplied toward securing the permit / any unauthorized changes are made to the site / any unauthorized changes are made in the installation of the system. **CONTACT A LOCATOR SERVICE PRIOR TO ANY EXCAVATION**

[ ] **IMPROVEMENT PERMIT** *with plat valid without expiration.* [X] **IMPROVEMENT PERMIT** *with site plan valid for 60 mos.* [X] **AUTHORIZATION TO CONSTRUCT** *valid for period equal to IMPROVEMENT PERMIT--not to exceed 60 mo.*

Owner / Applicant Signature: Michael W. Rash Mary Rash Date: 11-26-18 Installed by: A-1 BACKHOE

IMPROVEMENT PERMIT by: [signature] Date: 11-19-18 OPERATION PERMIT by: Burnett C. White Date: 7-19-2019

AUTHORIZATION TO CONSTRUCT by: [signature] Date: 11-19-18 Existing System Inspected by: Date:

FOR SEPTIC FINAL INSPECTION: CALL 704-664-3703 between 8am-9am the day the inspection is needed. Be sure to speak with an inpsector to confirm your inspection time.

DEPARTMENT OF HEALTH AND HUMAN SERVICES
DIVISION OF PUBLIC HEALTH, ENVIRONMENTAL HEALTH SECTION
ON-SITE WATER PROTECTION BRANCH

Sheet 1 of 1
PROPERTY ID #: 4811570752

SOIL/SITE EVALUATION
for ON-SITE WASTEWATER SYSTEM
(Complete all fields in full)

OWNER: Mike May Rock
ADDRESS: 536 Brookhaven Rd
PROPOSED FACILITY: Home
PROPOSED DESIGN FLOW (.1949): _____
LOCATION OF SITE: 538 Brookhaven

APPLICATION DATE: 10-29-18
DATE EVALUATED: 11-9-18
PROPERTY SIZE: 26.43
PROPERTY RECORDED: Yes

WATER SUPPLY: ☐ Private ☐ Public ☑ Well ☐ Spring ☐ Other _____
EVALUATION METHOD: ☐ Auger Boring ☑ Pit ☐ Cut
TYPE OF WASTEWATER: ☑ Sewage ☐ Industrial Process ☐ Mixed

PROFILE #	.1940 LANDSCAPE POSITION/ SLOPE %	HORIZON DEPTH (IN.)	SOIL MORPHOLOGY (.1941) .1941 STRUCTURE/ TEXTURE	SOIL MORPHOLOGY (.1941) .1941 CONSISTENCE/ MINERALOGY	OTHER PROFILE FACTORS .1942 SOIL WETNESS/ COLOR	.1943 SOIL DEPTH	.1956 SAPRO CLASS	.1944 RESTR HORIZ	PROFILE CLASS & LTAR
1	8%	0-8	SBK SCL	Fr SS SP Scp	PS	60"+	Sap inclusions 21-60	Rock inclusions 8-21	PS .288
		8-21	ABK C	Fr SS SP Scp					
		21-60	ABK/SBK CL	Fr SS SP Scp					
2	10%	0-5	SBK SCL	Fr SS SP Scp	PS	46"+	46"+	N/A	PS .275
		5-20	ABK C	Fr SP SS Scp					
		20-46	SBK CL	Fr SS SP Scp					
		46-60	Scp L						
3	10%	0-5	SBK SCL	Fr SS SP Scp	PS	58"+	52"+	N/A	PS .275
		5-29	ABK C	Fr SS SP Scp					
		29-52	SBK CL	Fr SS SP Scp					
		52-60	Scp L						
4	9%	0-4	SBK SCL	Fr SS SP Scp	PS	35"+	N/A	35"+	PS .275
		4-22	ABK L	Fr SS SP Scp					
		22-35	ABK CL	Fr SS SP Scp					
		35-60	Rock	F.m					

DESCRIPTION	INITIAL SYSTEM	REPAIR SYSTEM
Available Space (.1945)	218"	218"
System Type(s)	25%	25%
Site LTAR	.275	.275

OTHER FACTORS (.1946): _____
SITE CLASSIFICATION (.1948): PS
EVALUATED BY: James Boggs
OTHER(S) PRESENT: _____

COMMENTS: _____

LEGEND

use the following standard abbreviations

LANDSCAPE POSITION	GROUP	SOIL TEXTURE	CONVENTIONAL .1955 LTAR*	LPP .1957 LTAR*	MINERALOGY/ CONSISTENCE	STRUCTURE
CC (Concave Slope)	I	S (Sand)	1.2 - 0.8	0.6 - 0.4	SEXP (Slightly Expansive)	G (Single Grain)
CV (Convex Slope)		LS (Loamy Sand)			EXP (Expansive)	M (Massive)
D (Drainage Way)						CR (Crumb)
DS (Debris Slump)	II	SL (Sandy Loam)	0.8 - 0.6	0.4 - 0.3		GR (Granular)
FP (Flood Plain)		L (Loam)				SBK (Subangular Blocky)
FS (Foot Slope)						ABK (Angular Blocky)
H (Head Slope)	III	Si (Silt)	0.6 - 0.3	0.3 - 0.15		PL (Platy)
L (Linear Slope)		SiCL (Silty Clay Loam)				PR (Prismatic)
N (Nose Slope)		CL (Clay Loam)				
R (Ridge)		SCL (Sandy Clay Loam)			**MOIST**	**WET**
S (Shoulder Slope)		SiL (Silt Loam)				
T (Terrace)					VFR (Very Friable)	NS (Non-sticky)
	IV	SC (Sandy Clay)	0.4 - 0.1	0.2 - 0.05	FR (Friable)	SS (Slightly Sticky)
		SiC (Silty Clay)			FI (Firm)	S (Sticky)
		C (Clay)			VFI (Very Firm v. Very Sticky)	VS (Very Sticky)
		O (Organic)	None	None	EFI (Extremely Firm)	NP (Non-plastic)
						SP (Slightly Plastic)
						P (Plastic)
						VP (Very Plastic)

*Adjust LTAR due to depth, consistence, structure, soil wetness, landscape, position, wastewater flow and quality.


NOTES

HORIZON DEPTH	In inches below natural soil surface
DEPTH OF FILL	In inches from land surface
RESTRICTIVE HORIZON	Thickness and depth from land surface
SAPROLITE	S(suitable) or U(unsuitable)
SOIL WETNESS	Inches from land surface to free water or inches from land surface to soil colors with chroma 2 or less - record Munsell color chip designation
CLASSIFICATION	S (Suitable), PS (Provisionally Suitable), or U (Unsuitable)

Evaluation of saprolite shall be by pits.

Long-term Acceptance Rate (LTAR): gal/day/ft^2

Show profile locations and other site features (dimensions, reference or benchmark, and North).

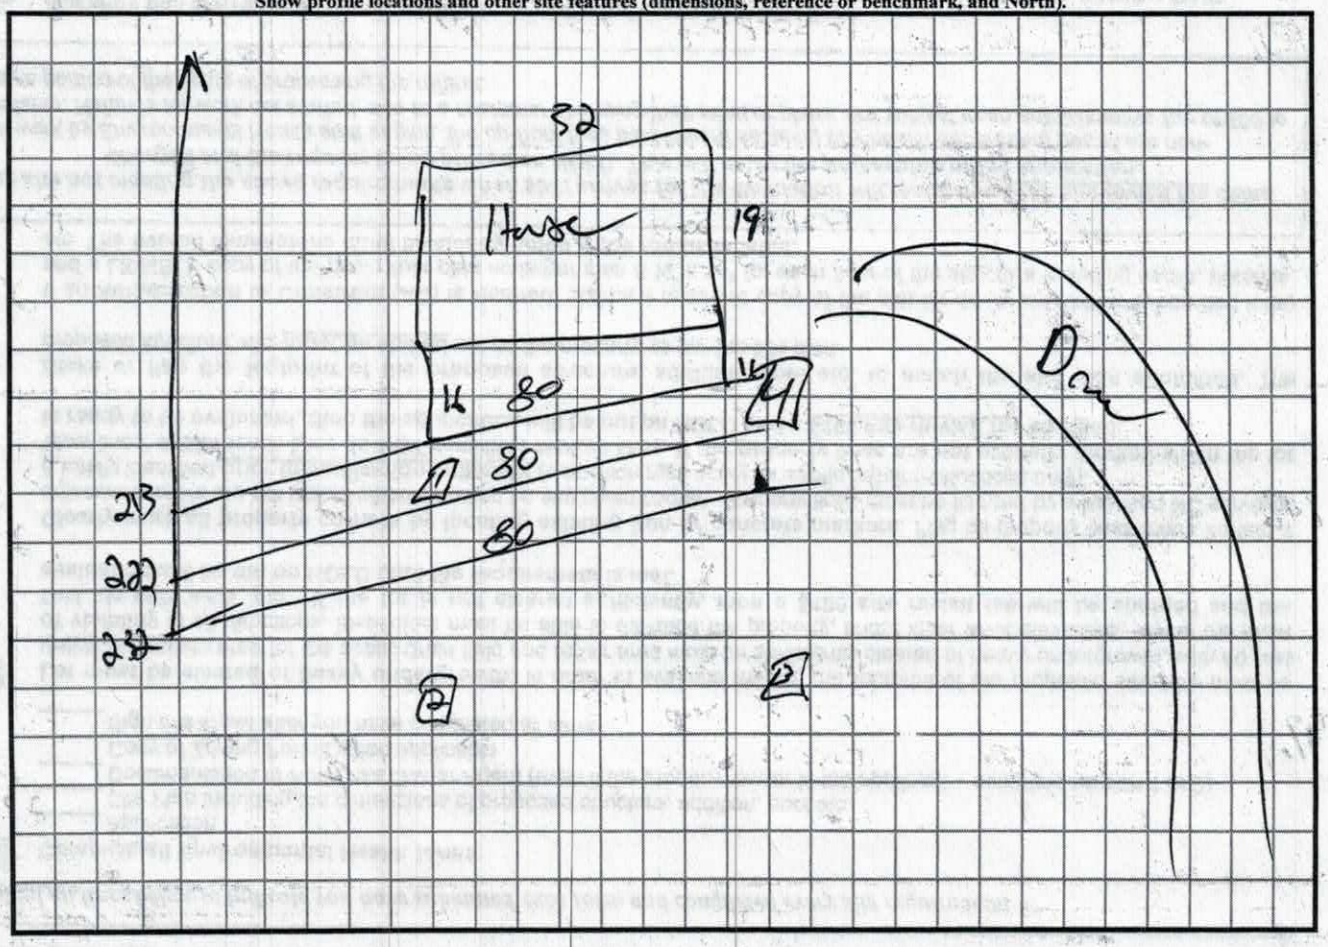

RECEIVED OCT 3 0 2018

239902
Paid $500.00

IREDELL COUNTY DEPARTMENT of ENVIRONMENTAL HEALTH

APPLICATION FORM

Application For: ( ) New Well Permit ( ) Well Repair Permit ( ) Well Abandonment
( ) Septic Improvement Permit (✓) Authorization to Construct ( ) Existing System Inspection ( ) Septic System Repair

THE ABOVE PERMIT DOCUMENTS WILL BECOME INVALID IF INFORMATION PROVIDED ON THIS APPLICATION IS FALSIFIED OR CHANGED, OR IF THE SITE IS ALTERED. THE IMPROVEMENT PERMIT IS VALID FOR EITHER 60 MONTHS OR WITHOUT EXPIRATION DEPENDING UPON DOCUMENTATION SUBMITTED. APPLICATION WITH SITE PLAN 60 MONTHS, APPLICATION WITH COMPLETE, SCALED PLAT WITHOUT EXPIRATION. SEE 15A NCAC 18A .1937(f) FOR DETAILS.

Page 2: *Site Plan Worksheet* form MUST accompany this application

The following optional attachments may also be submitted: ( ) Survey Plat, scaled no more than 1 inch = 60 feet
Place an (X) beside whichever is submitted if applicable ( ) Custom Site Plan, scaled no more than 1 inch = 60 feet

Applicant Information: (PRINT CLEARLY)

Applicant Name: Michael W. / Mary K. Rash Address: 202 Ottare Farm Ln. (536 Brookhaven Rd) - GPS Zip: 28625

Applicant Email: jrashottare@gmail.com Phone: (704) 592-2791 Alt. Phone: —

Owner Name: same Address: same Zip: —

Owner Email: — Phone: — Alt. Phone: —

Property Information:

MWR
ME

Street Address: 538 Brookhaven Rd , Statesville, NC 28625

Subdivision Name: — Section/Phase: ____ Lot Number: ____

Driving Directions: Hwy 115 North to Brookhaven Rd. - left; 2 miles to Ottare Farm on right; proceed up drive, down to little barn-site across road

Site Development Information: *(check or complete ALL that apply*

CHECK FOUNDATION TYPE

(✓) New Single Family Residence
( ) New Multi-Family Residence
( ) Accessory Building
( ) Bedroom(s) Addition
( ) Repair to failing septic system ___ Tank ___ Drain lines Describe Problem: ____

Maximum Number of Bedrooms: 1
Maximum Number of Occupants: 2
( ) Swimming Pool
( ) Other Addition/Structure: ____

(✓) Crawl Space Foundation
( ) Concrete Slab Foundation
( ) Basement with Plumbing
( ) Basement without Plumbing

Non-Residential Site Development: Type of Business: ____
Square Footage of Building: ____ Max. Number of Employees: ____ Max. Number of Seats/Beds/Other: ____

Water Supply: ( ) Replacement Well – Reason: ____
(✓) Multi-connection Well Number of Houses: 2 Number of Persons: 3

( ) New Well (✓) Existing Well ( ) Community Well ( ) City Water ( ) Other Public Water

Desired Septic System Type: *(you may rank in order of preference)* Year existing system installed: bc forc 1983
( ) No Preference ( ) Alternative (✓) Conventional ( ) Innovative ( ) Modified Conventional ( ) Other: ____

Please answer the following to the best of your ability:

( ) Yes (✓) No Does the site contain any jurisdictional wetlands?
( ) Yes (✓) No Is any non-domestic sewage (i.e. industrial) to be generated?
( ) Yes (✓) No Is the site subject to approval by any other public agency?

I have read this application and certify that the information provided herein is true, complete, and correct. Authorized county and state officials are granted right of entry to conduct necessary inspections to determine compliance with applicable laws and rules. I understand that I am solely responsible for the proper identification and labeling of all property lines and corners and making the site accessible so that a complete site evaluation can be performed.

Signature: Michael W. Rash Mary K. Rash 10/29/18
Property owner or owner's legal representative signature (SIGNATURE REQUIRED) DATE


IREDELL COUNTY DEPARTMENT of ENVIRONMENTAL HEALTH

SITE PLAN WORKSHEET

SEE THE "SAMPLE SITE PLAN" BELOW. *INCOMPLETE SITE PLANS WILL BE RETURNED TO YOU FOR COMPLETION AND MAY RESULT IN A DELAY IN THE ISSUANCE OF YOUR SEPTIC SYSTEM OR WELL PERMIT!!!*

Place an (X) beside each item as you complete the site plan:

- (X) Property Line measurements are clearly identified
- (X) All proposed structures are indicated
- (X) Front and side setbacks from property line
- (X) Preferred driveway location
- (X) Preferred well location
- (X) Preferred septic system location
- (X) North arrow, or other sufficient indicator of direction

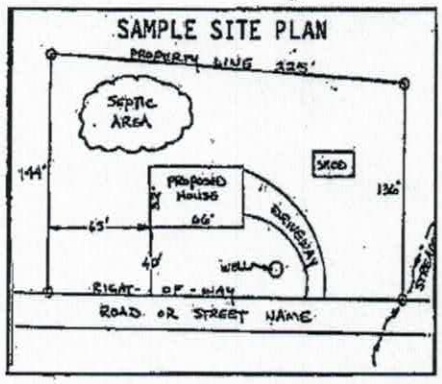


Circle N/A on the following if appropriate:

Location of septic systems and wells within 100' of your property N/A
Location of easements and rights of ways on your property N/A
Location of any designated wetlands on the property N/A

USE THIS SPACE TO DRAW YOUR SITE PLAN

Show: proposed house or business footprint, wells, water lines, patios, pools and decks, and any other item that will occupy space on the site

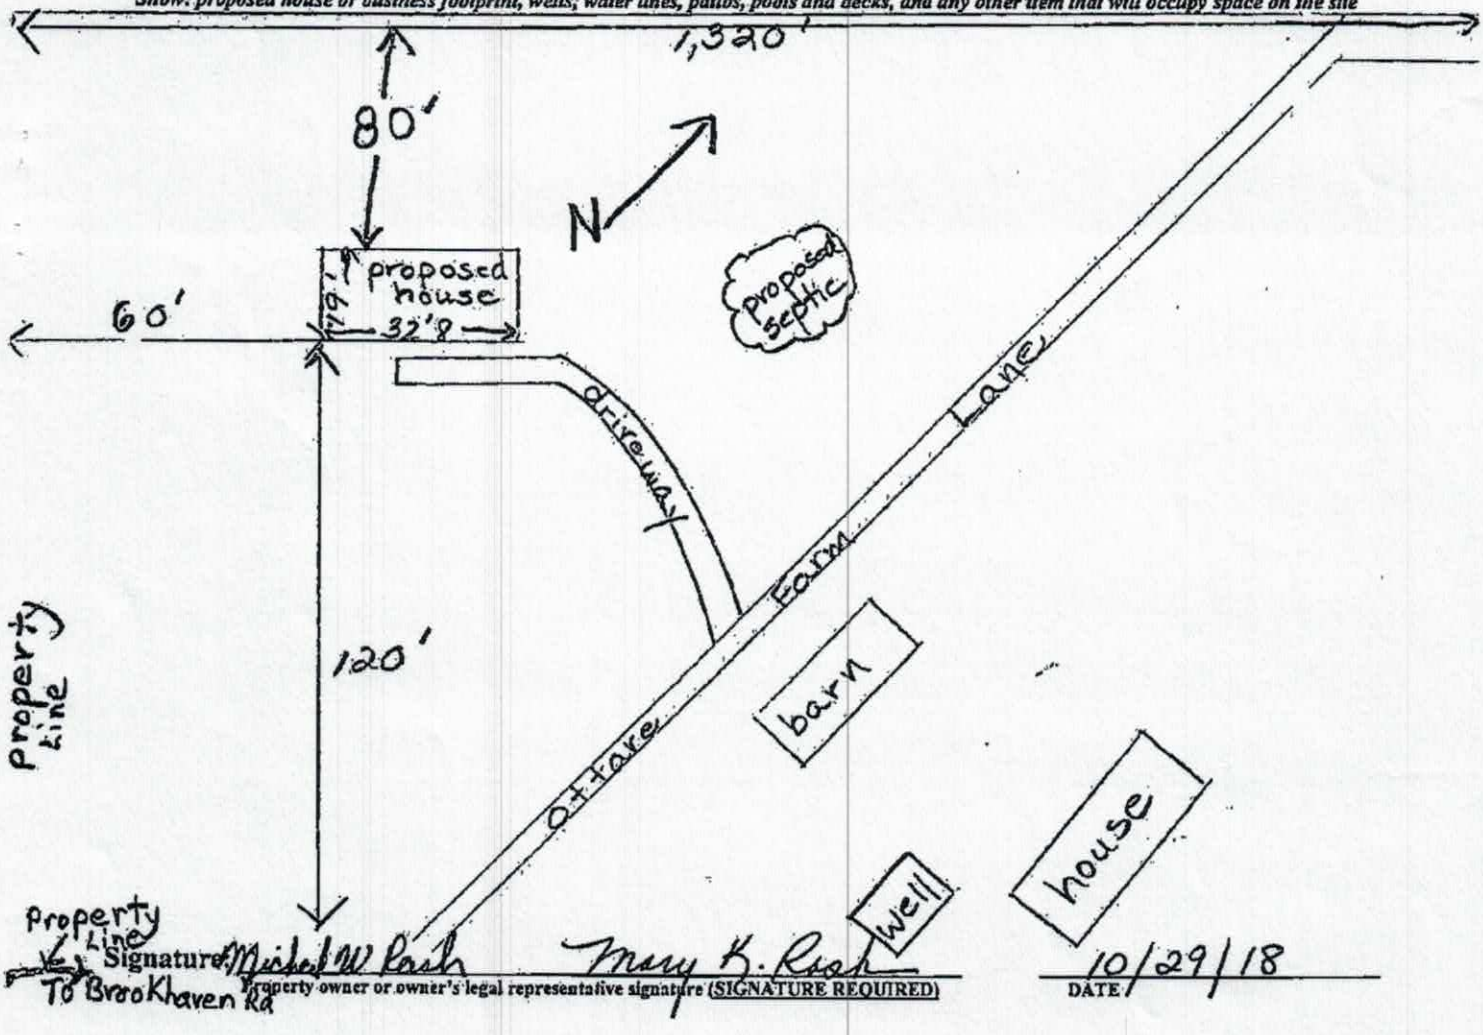

Signature: Michael W Rash Mary K. Rash
Property owner or owner's legal representative signature (SIGNATURE REQUIRED)

DATE: 10/29/18

IREDELL COUNTY DEPARTMENT OF ENVIRONMENTAL HEALTH

DOCUMENTATION TO AUTHORIZE AN OWNER'S LEGAL REPRESENTATIVE

(Check and sign only ONE of the options below)

1. *** APPLICANT AND OWNER ARE THE SAME..*** *(Sign here)* Michael W Rash Mary K. Rash

Applications for permits require the "signature of the owner or owner's legal representative" (15A NCAC 18A .1937). If the owner does not sign the application himself or herself, they can submit any one of the following documents to designate their legal representative: *Power of Attorney; Real Estate Contract; Estate executor; Bankruptcy trustee; Court ordered guardianship* In the absence of the above documentation, the property owner may provide the local health department with documentation that designates a legal representative. A property owner may:
Complete this form to document his or her legal representative, or provide his or her own form that contains the information in this form. If there are multiple property owners, then all property owners must sign the form that designates a legal representative.
By signing a form that designates a legal representative for purposes of 15A NCAC 18A .1937, the property owner authorizes that representative to act on their behalf in matters pertaining to the application and permitting process, including signing or receiving any application, document or permit. The owner retains full responsibility to meet all permit conditions specified by the local health department.

2. I, _____, am the legal owner(s) of the property located at _____, identified as

PIN (Parcel Identification Number)_____, located in Iredell County, North Carolina.

I do hereby authorize **(print legal representative/company name)** _____, _____, to act as an agent on my behalf in applying for/signing/obtaining any of the documents described below.


- Application for Improvement Permit (IP) / Authorization to Construct (AC)
- Improvement Permit (IP) / Authorization to Construct (AC)
- Application for soil-site evaluation (new/repair)
- Application/permit for private drinking water well/well abandonment
- Application for Compliance Inspection

I agree to abide by all decisions and/or conditions between the legal representative acting on my behalf and the Iredell County Department of Public Health, Environmental Health Division.

Michael W Rash Mary K Rash _____ 10 _____
Signature of Owner(s) Date

Mooresville - Environmental Health
ronda.hart@co.iredell.nc.us
Fax: 704-662-3239
610 E. Center Avenue, Mooresville, NC 28115

Statesville - Environmental Health
adrienne.shea@co.iredell.nc.us
Fax: 704-871-3483
349 N. Center Street, Statesville, NC 28677

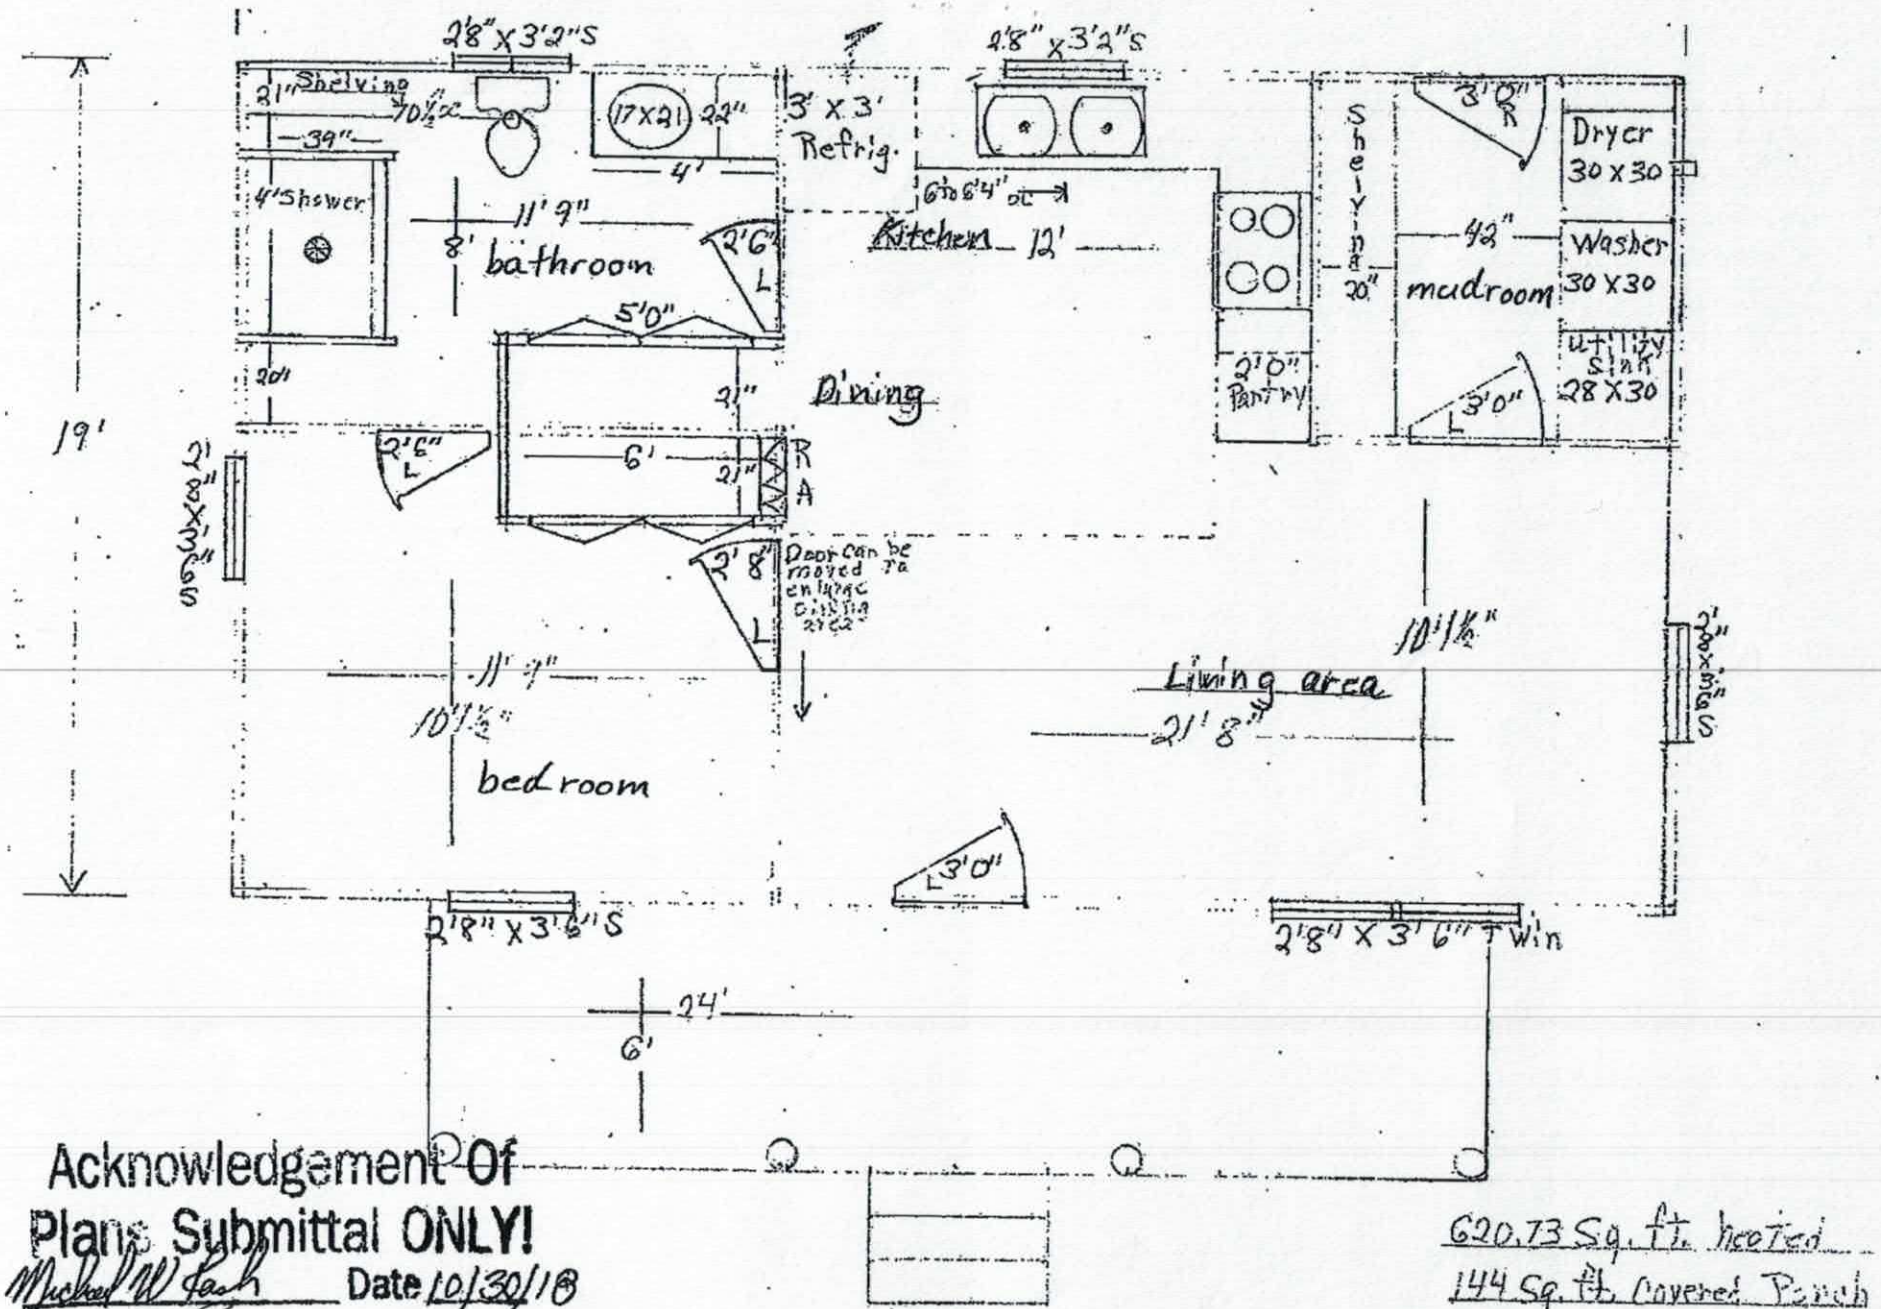

Acknowledgement Of
Plans Submittal ONLY!

Michael W Lash Date 10/30/18

Date 11-19-18

620.73 Sq. ft. heated
144 Sq. ft. Covered Porch

IREDELL COUNTY

PO Box 788
349 North Center St.
Statesville, NC 28677

APPLICATION NUMBER
239902
Issue Date: 10/30/2018

ZONING PERMIT

Residential

Parcel Number	Street Address	Jurisdiction
4811570752.000	538 BROOKHAVEN ROAD, STATESVILLE, NC 28625	IREDELL COUNTY

Owner Information	Applicant Information
Owner: RASH MICHAEL WADE+MARY	Applicant: RASH MICHAEL WADE+MARY
Address: 202 OTTARE FARM LANE	Address: 202 OTTARE FARM LANE
STATESVILLE, NC 28625	STATESVILLE, NC 28625
Phone:	Phone:

Use Requested	Zone Code
	RA

Lot Acreage	F Setback	B Setback	L Setback	R Setback	Watershed	Flood Zone
26.430	50.00	50.00	50.00	50.00	PASY	X

Remarks:

100 FEET BETWEEN DWELLINGS.


The applicant certifies that there are no deed restrictions, contractual agreements or governmental regulations of any kind that interfere with or prohibit the use of the property or the use for which this permit is requested. The applicant further acknowledges that enforcement of deed restrictions, plat conditions and other contractual agreements will not be undertaken by Iredell County and is the sole responsibility of the affected parties.

Applicant: _____ Date: _____

Permit Number	157233	TOTAL FEES:	$ 77.25

ZONING APPROVAL
W. Allen 10/29/18
WILLIAM ALLISON

ZONING DISCLAIMER

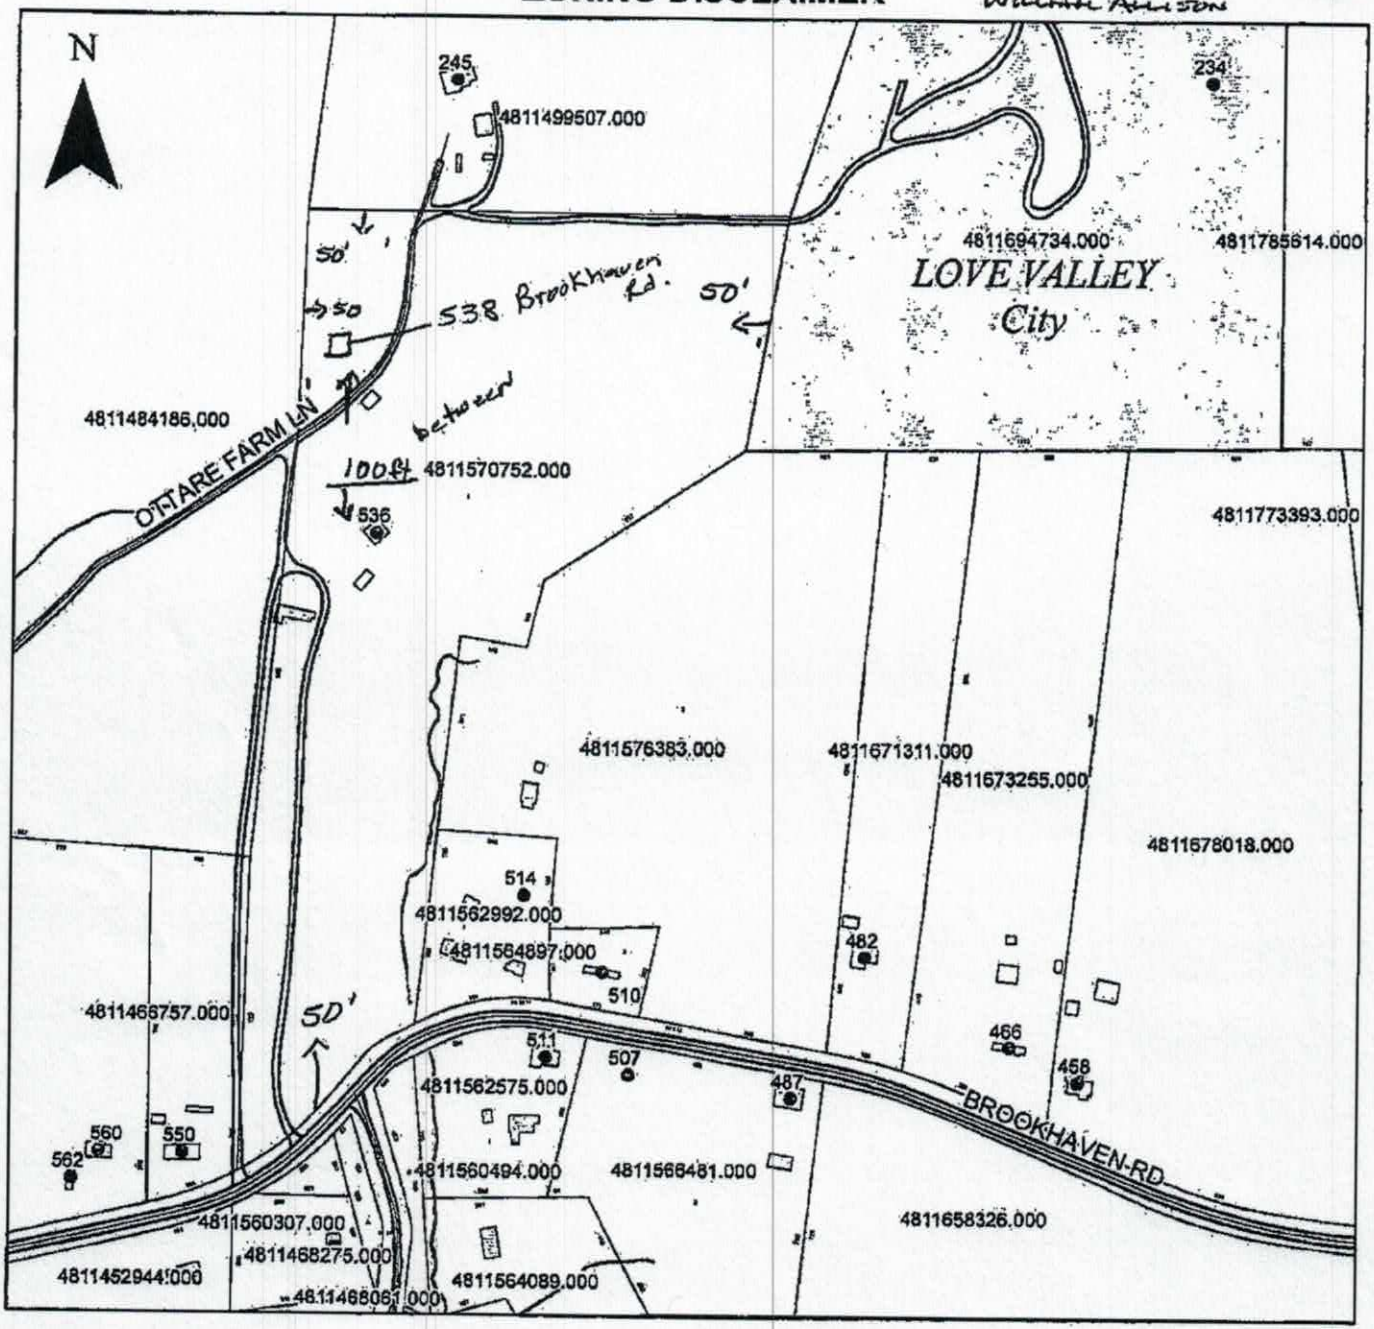

Property Address 538 Brookhaven Rd.

The applicant certifies that there are no deed restrictions, contractual agreements or governmental regulations of any kind that interfere with or prohibit the use of the property or the use for which this permit is requested. Applicant further acknowledges that the enforcement of deed restrictions, plat conditions, and other contractual agreements will not be undertaken by Iredell County and is the sole responsibility of the affected parties.

Michael W Rash Mary K Rash
Applicant

10/30/18
Date