IREDELL COUNTY HEALTH DEPARTMENT

STATESVILLE 704-878-5305 (C1) MOORESVILLE 704-664-5281

IMPROVEMENT PERMIT / AUTHORIZATION TO CONSTRUCT / OPERATION PERMIT / EXISTING SYSTEM INSPECTION

PERMIT# 140249 PIN# 4911-69-4734 DATE 9 February 07

OWNER OR APPLICANT Wesley Jo Williams PHONE: Business 704-902-1460 Home

ADDRESS 487 Brookhaven RD. Statesville, N.C.

LOCATION Hwy 115N TL Brookhaven Rd. 2miles on Rt. 544 Brookhaven Rd. Statesville

SUBDIVISION BLOCK / SECTION LOT LOT AREA 89 ac. SITE CLASS. PS DESIGN FLOW 240 g/d L.T.A.R. 0.3 g/ft²/d

Septic Tank: 1000 Gallons; STB 760 Date 10-25-09
Pump Tank: Gallons; PT Date
Pump Make: Model Serial No.
Nitrification Field: No Fields Square Feet Lineal Feet
No Lines 2 Trench Width 36" Max Trench Bottom Depth 30"

☑ New System ☐ Repair ☐ Expansion System Type: I II III IV V VI
System Description: 25% Reduction
Repair System Description: 25% Reduction
Maintenance Agreement Required: ☐ Yes ☑ No
Gravel Depth NA ☑ Gravity ☐ Pressure

☑ House/Mod. Home No. Bedrooms 2
☐ Mobile Home No. Persons
☐ Business No. Employees
☐ Other


Water Supply: ☑ Individual ☐ Public ☐ Community

☐ Slab ☑ Crawl Space ☐ Basement w/plumbing ☐ Basement wo/plumbing

Comments:/Conditions: Follow contour / Keep well 100' from system. / USE 2 drop boxes.

Comments:/Conditions:

INITIAL SITE SKETCH

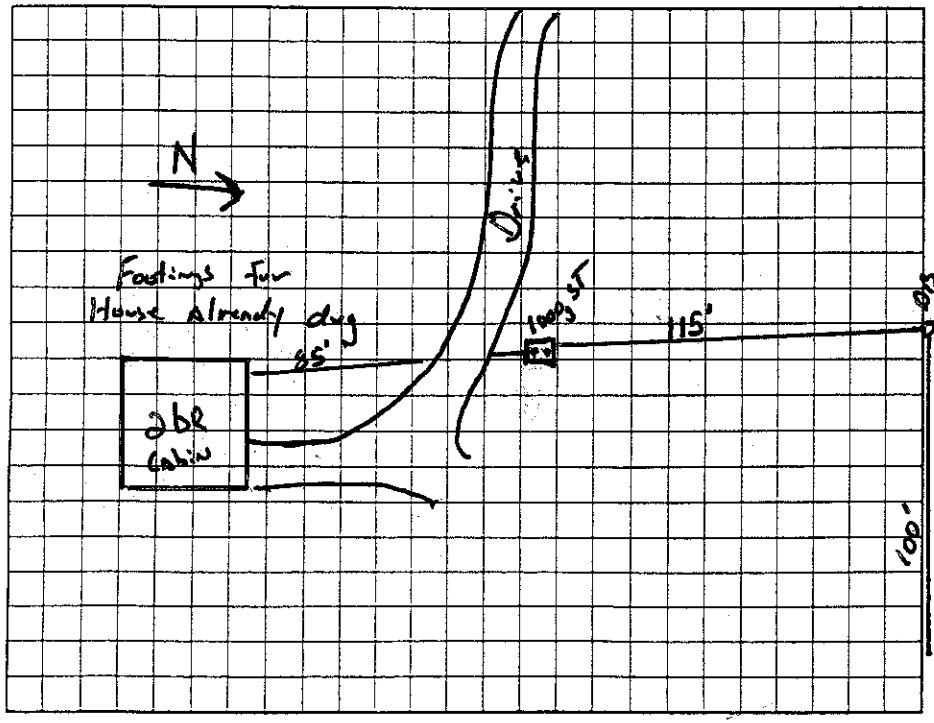

AS BUILT SKETCH

SYSTEM INSTALLED ACCORDING TO INITIAL SITE SKETCH

Permit can be suspended or revoked if any false information is supplied toward securing the permit/any unauthorized changes are made to the site/any unauthorized changes are made in the installation of the system. Improvement Permit with plat valid without expiration ☐ Improvement Permit with site plan valid for sixty months ☑ Authorization to Construct is valid for a period equal to that of Improvement Permit – not to exceed sixty months.

Signed: date

Improvement Permit by: , R.S. date 9 Feb. 07

Authorization to Construct by: , R.S. date 9 Feb. 07

Installed by: JARED LENTZ

Operation Permit by: STEVE HENDRICK date 4-9-09

Existing System Inspection by: date

HEALTH DEPT. COPY: WHITE OWNER COPY (FINAL): YELLOW OWNER COPY (INITIAL): PINK