IREDELL COUNTY HEALTH DEPARTMENT

STATESVILLE 704-878-5305 (C1) MOORESVILLE 704-664-5281

IMPROVEMENT PERMIT / AUTHORIZATION TO CONSTRUCT / OPERATION PERMIT / EXISTING SYSTEM INSPECTION

PERMIT# 111081 PIN# 4811-81-~~3307~~ 8741 DATE 2-21-03

OWNER OR CONTRACTOR LAKE PROPERTIES PHONE: Business 704-972-1699 Home 704-664-7250

ADDRESS 249 WILLIAMSON ROAD, MOORESVILLE, NC 28117

LOCATION NC115 NORTH, TL CROSS COUNTRY ROAD, 0.7 MILE ON RIGHT

SUBDIVISION _____ BLOCK / SECTION _____ LOT 1 LOT AREA 24.63 ACRES SITE CLASS. PS DESIGN FLOW 360 L.T.A.R. 0.25 GPD/FT²

Septic Tank: 1000 Gallons; STB 1012 Date 6-303
Pump Tank: _____ Gallons; PT _____ Date _____
Pump Make: _____ Model _____ Serial No. _____
Nitrification Field: No Fields 1 Square Feet 1440 Linear Feet 480
No Lines SIX Trench Width 36" Max Trench Bottom Depth 36" Gravel Depth 12"

☒ New System ☐ Repair System Type: I (II) III. IV. V. VI
System Description: CONVENTIONAL, GRAVITY
Repair System Description: CONVENTIONAL, GRAVITY
Maintenance Agreement Required: ☐ Yes ☒ No

☒ House/Mod. Home No. Bedrooms 3
☐ Mobile Home No. Bathrooms 4
☐ Business No. Employees ____
☐ Other _____


☐ Slab ☒ Crawl Space ☐ Basement w/plumbing ☐ Basement wo/plumbing

Water Supply: ☒ Individual ☐ Public ☐ Community WELL


Comments/Conditions: ① INSTALL SUBSURFACE INTERCEPT DRAINAGE DITCH BEGINNING 48" DEEP OUT TO DAYLIGHT AS SHOWN. ② KEEP SYSTEM MINIMUM 100 FEET FROM WELL.

Comments/Conditions: SEPTIC TANK WITH MARKER INSTALLED USING "TUFTITE" FILTER

INITIAL SITE SKETCH

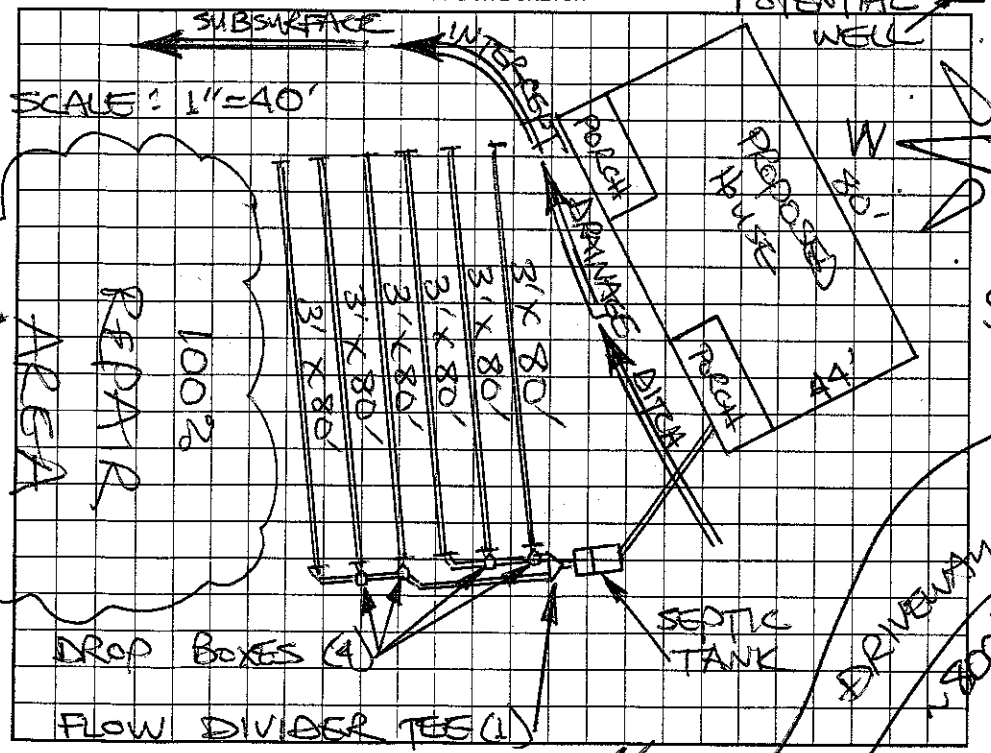

AS BUILT SKETCH

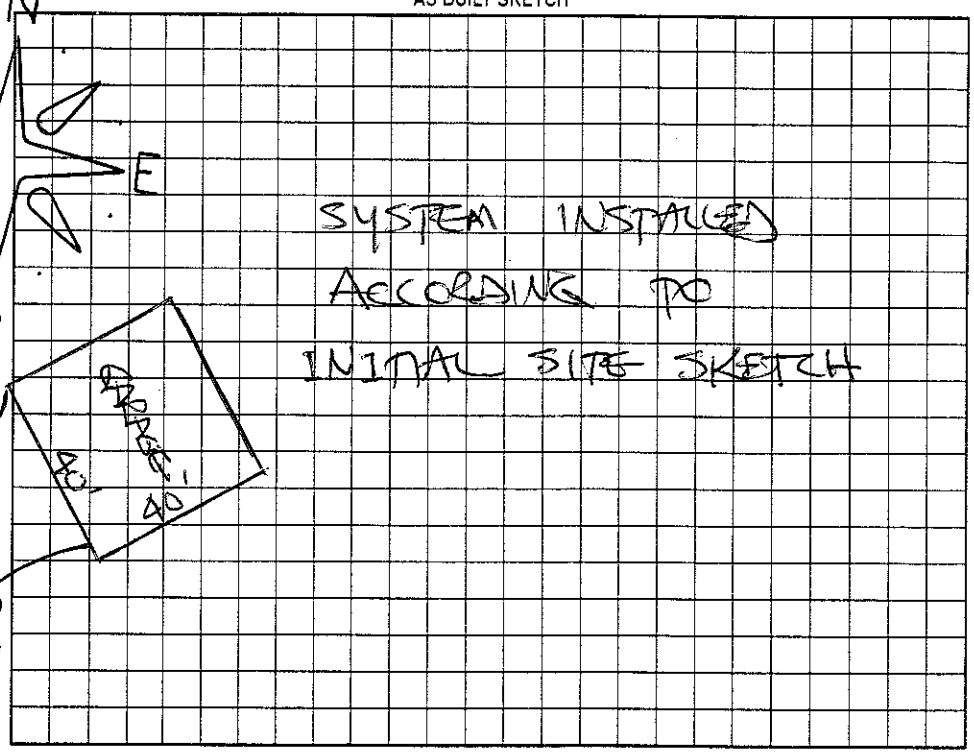

Permit can be suspended or revoked if any false information is supplied toward securing the permit, any unauthorized changes are made to the site, any unauthorized changes are made in the installation of the system. Improvement Permit with plat valid without expiration. Improvement Permit with site plan valid for sixty months. Authorization to Construct is valid for a period equal to that of Improvement Permit – not to exceed sixty months.

Signed: _____ date 2/21/03 Installed by: A-1 BACKHOE

Improvement Permit by: STEVE HEDRICK date 2-21-03 Operation Permit by: STEVE HEDRICK date 11-26-03

Authorization to Construct by: STEVE HEDRICK date 2-21-03 Existing System Inspection by: _____ date _____

HEALTH DEPT. COPY: WHITE OWNER COPY (FINAL): YELLOW OWNER COPY (INITIAL): PINK