IREDELL COUNTY HEALTH DEPARTMENT

STATESVILLE 704-878-5305 MOORESVILLE 704-664-5281

IMPROVEMENT PERMIT / AUTHORIZATION TO CONSTRUCT / OPERATION PERMIT / EXISTING SYSTEM INSPECTION

PERMIT# 079509 PIN# 4821 00 3329 DATE 3-8-99

OWNER OR CONTRACTOR JOHN WILLIAMS PHONE: Business Home 876-4967

ADDRESS 220 CROSS COUNTRY ROAD STATESVILLE NC 28625

LOCATION NC 115 N, TL CROSS COUNTRY ROAD 0.4 MILE ON ~~LEFT~~ RIGHT

SUBDIVISION BLOCK / SECTION LOT LOT AREA 27.79 ACRES SITE CLASS PS DESIGN FLOW 360 L.T.A.R. 0.30 GPD/FT²

Septic Tank: 1000 Gallons: STB 1017 Date 1-8-99

Pump Tank: Gallons: PT Date

Pump Make: Model Serial No.

Nitrification Field: No Fields 1 Square Feet 1200 Linear Feet 400

No Lines THREE Trench Width 36" Max Trench Bottom Depth 36" Gravel Depth 12"

(X) New System ( ) Repair System Type: (I) (II) III. IV. V. VI

System Description: CONVENTIONAL GRAVITY

Repair System Description: CONV. GRAVITY

Maintenance Agreement Required: ( ) Yes (X) No

Future

( ) House/Mod. Home No. Bedrooms 3

( ) Mobile Home No. Bathrooms 3

( ) Business No. Employees

( ) Other


( ) Slab (X) Crawl Space ( ) Basement w/plumbing ( ) Basement wo/plumbing

Water Supply: (X) Individual ( ) Public ( ) Community WELL


Comments/Conditions: (1) KEEP SYSTEM MINIMUM 100 FEET FROM WELL (2) S/W MH TO BE REMOVED UPON OCCUPANCY OF HOUSE

Comments/Conditions: SEPTIC TANK WITH RISERS INSTALLED W/ "POLYLOK" FILTER

INITIAL SITE SKETCH

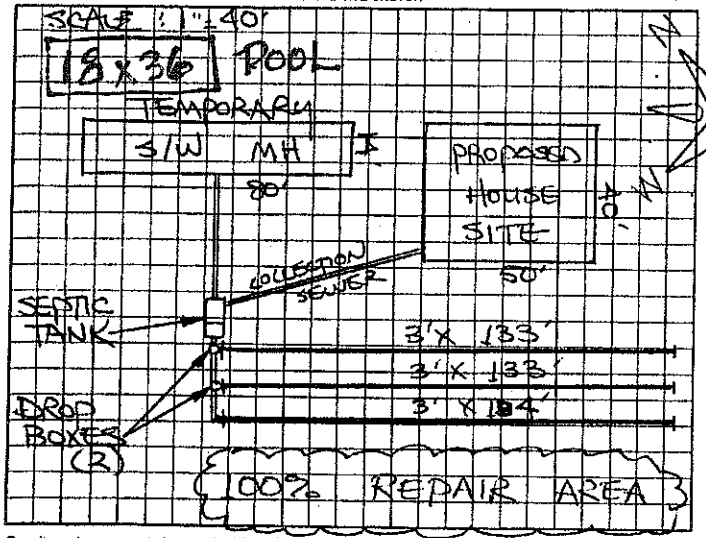

AS BUILT SKETCH

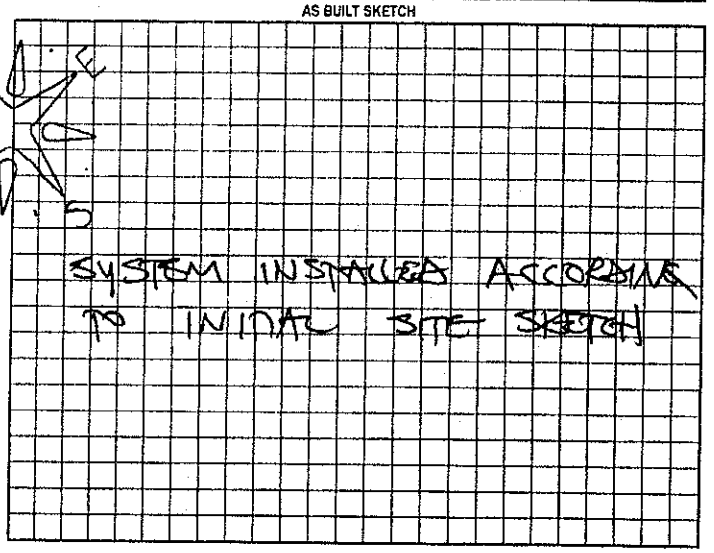

Permit can be suspended or revoked if any false information is supplied toward securing the permit/any unauthorized changes are made to the site/any unauthorized changes are made in the installation of the system. Improvement Permit with plat valid without expiration. Improvement Permit with site plan valid for sixty months. Authorization to Construct is valid for a period equal to that of Improvement Permit -- not to exceed sixty months.

Signed: [signature] date 3-8-99

Improvement Permit by: STEVE HEDRICK date 3-8-99

Authorization to Construct by: STEVE HEDRICK date 3-8-99

Installed by: KENNY MADISON

Operation Permit by: STEVE HEDRICK date 3-19-99

Existing System Inspection by: date

HEALTH DEPT COPY: WHITE OWNER COPY (FINAL): YELLOW OWNER COPY (INITIAL): PINK

Location of the proposed Swimming Pool addition does not appear to impact the existing on-site septic system.**NOTE:

[signature] REHS

Date: 13 MAY 2011

ICHD-Environmental Health Division