IREDELL COUNTY HEALTH DEPARTMENT

This permit voids previous issued 5-3-04

STATESVILLE 704-878-5305 MOORESVILLE 704-664-5281

IMPROVEMENT PERMIT / AUTHORIZATION TO CONSTRUCT / OPERATION PERMIT / EXISTING SYSTEM INSPECTION

PERMIT# LOVE VALLEY PIN# 4812-10-5664 DATE 7-25-05

OWNER OR CONTRACTOR CATHY CLARK PHONE: Business 704-585-2492 Home 704-592-4905

ADDRESS 109 GODFREY PASS, STATESVILLE, NC 28625

LOCATION NC 115 N, TL MOUNTAIN VIEW RD, TR LOVE VALLEY RD, TL MITCHELL TRAIL, ON RIGHT JUST PAST JUDE DR

SUBDIVISION 1500 BLOCK / SECTION ____ LOT ____ LOT AREA 0.33 ACRE SITE CLASS PS DESIGN FLOW 240 L.T.A.R. 0.40 GPD/FT²

Septic Tank: 1000 Gallons; STB 2 BR Date 9-27-07

Pump Tank: ____ Gallons; PT ____ Date ____

Pump Make: ____ Model ____ Serial No. ____

Nitrification Field: No. Fields 1 Square Feet 450 Linear Feet 150

No Lines TREE Trench Width 36" Max Trench Bottom Depth 36" Gravel Depth N/A

☑ New System ☐ Repair System Type: I II III IV V VI

System Description: 25% REDUCTION GRAVITY

Repair System Description: MAX. FEASIBLE

Maintenance Agreement Required: ☐ Yes ☑ No

☐ House/Mod. Home ☑ Mobile Home ☐ Business ☐ Other

No. Bedrooms 2 No. Bathrooms 2 No. Employees ____


☐ Slab ☑ Crawl Space ☐ Basement w/plumbing ☐ Basement wo/plumbing

Water Supply: ☐ Individual ☑ Public ☐ Community


Comments:/Conditions: INSTALL 25% REDUCTION SYSTEM ON CONTOUR AS SHOWN & FLAGGED ON SITE

Comments:/Conditions: Filter install.

INITIAL SITE SKETCH ~ SCALE 1" = 30'

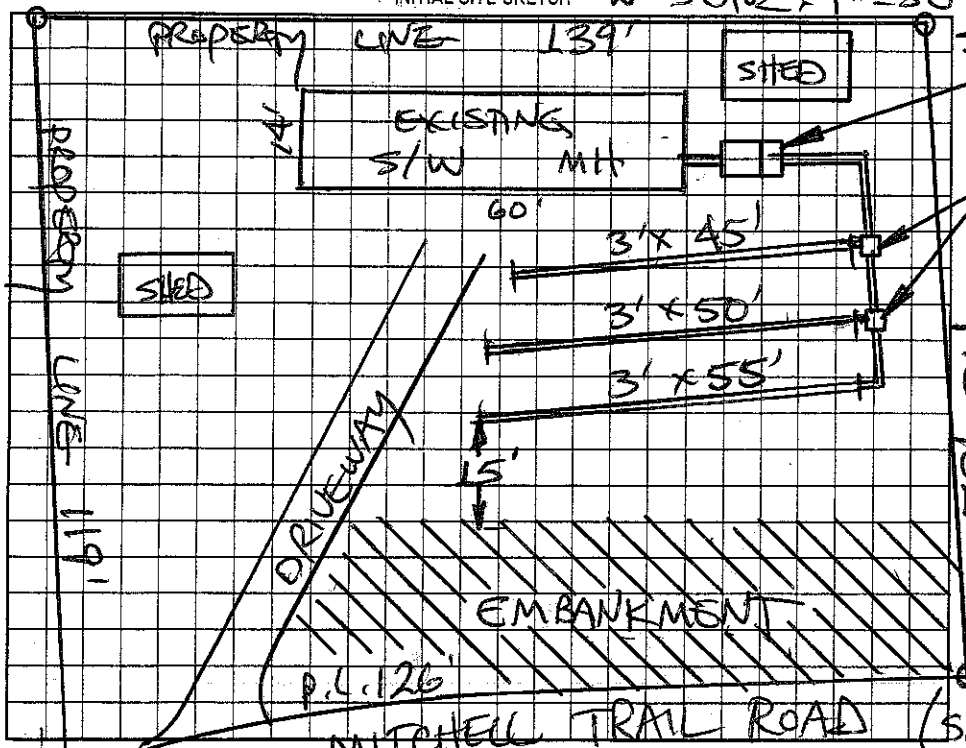

AS BUILT SKETCH

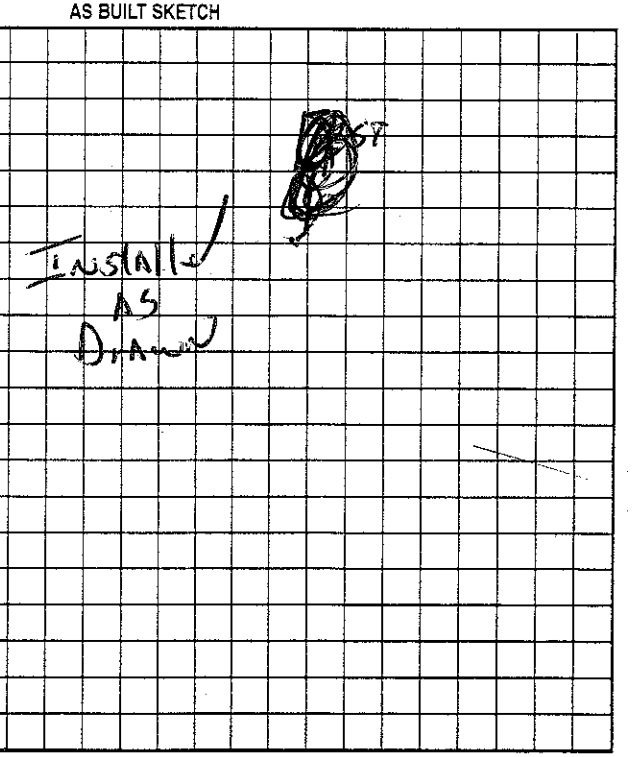

Permit can be suspended or revoked if any false information is supplied toward securing the permit/any unauthorized changes are made to the site/any unauthorized changes are made in the installation of the system. Improvement Permit with plat valid without expiration. Improvement Permit with site plan valid for sixty months. Authorization to Construct is valid for a period equal to that of Improvement Permit – not to exceed sixty months.

Signed: Cathy Clark date 8-22-05 Installed by: Andy Daniels

Improvement Permit by: STEVE HEDRICK date 7-25-05 Operation Permit by: [signature], R.S. date 14 Nov 07

Authorization to Construct by: STEVE HEDRICK date 7-25-05 Existing System Inspection by: ____ date ____

HEALTH DEPT. COPY: WHITE OWNER COPY (FINAL): YELLOW OWNER COPY (INITIAL): PINK