Called 6-26-07 @ 3:42

IREDELL COUNTY HEALTH DEPARTMENT

STATESVILLE 704-878-5305 MOORESVILLE 704-664-5281

IMPROVEMENT PERMIT / AUTHORIZATION TO CONSTRUCT / OPERATION PERMIT / EXISTING SYSTEM INSPECTION

PERMIT# 153722 PIN# 4812-10-6478 DATE 6-6-2007

OWNER OR APPLICANT ROBERT G. ADAMS PHONE: Business 704-592-5311 Home 704-592-5051

ADDRESS 279 MITCHELL TRAIL STATESVILLE NC 28625

LOCATION NC 115 NORTH, TL MTN. VIEW RD, TR LOVE VALLEY RD, CONTINUE HENRY MARTIN TRAIL, END ON LEFT

SUBDIVISION _____ BLOCK / SECTION _____ LOT _____ LOT AREA LIMITED SITE CLASS PS DESIGN FLOW 1500 L.T.A.R. EXISTING

* Septic Tank: 1500 Gallons: STB 1011 Date 8-18-06
Pump Tank: _____ Gallons; PT _____ Date _____
Pump Make: _____ Model _____ Serial No. _____
Nitrification Field: No Fields 1 Square Feet EX Linear Feet EXISTING
No Lines EXISTING Trench Width EX Max Trench Bottom Depth 60 Gravel Depth EX

☐ New System ☐ Repair ☑ Expansion System Type: II III IV V VI
System Description: CONVENTIONAL GRAVITY
Repair System Description: _____
Maintenance Agreement Required: ☐ Yes ☑ No
☑ Gravity ☐ Pressure ☐ Slab ☐ Crawl Space ☑ Basement w/plumbing ☐ Basement wo/plumbing


☐ House/Mod. Home No. Bedrooms ____
☐ Mobile Home No. Persons ____
☑ Business No. Employees 2
☐ Other CAFE @ 200 MAX

Water Supply:
☐ Individual
☑ Public
☐ Community

Comments/Conditions: INSTALL 1500 GALLON "TRAFFIC RATED" GREASE TRAP AT LOCATION SHOWN. ACCESS RISERS SHALL EXTEND TO SURFACE.

Comments/Conditions:

INITIAL SITE SKETCH

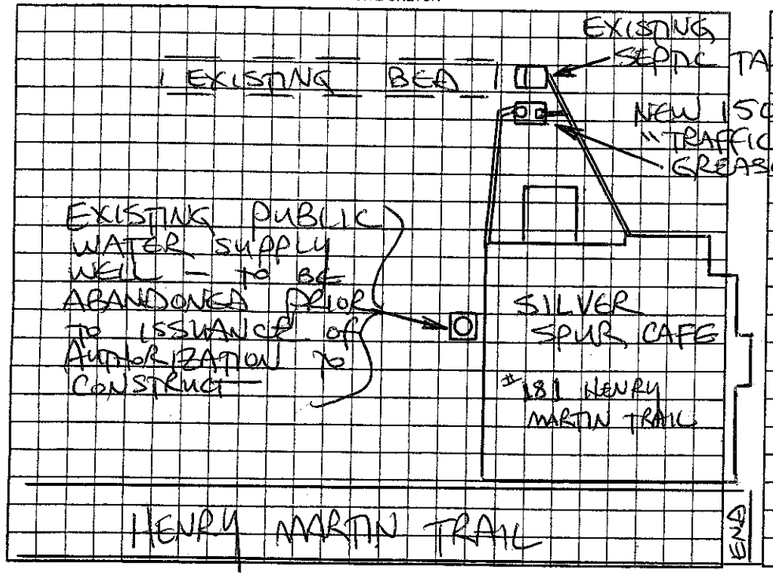

AS BUILT SKETCH

Installed As Drawn

Permit can be suspended or revoked if any false information is supplied toward securing the permit/any unauthorized changes are made to the site/any unauthorized changes are made in the installation of the system. Improvement Permit with plat valid without expiration ☐ Improvement Permit with site plan valid for sixty months ☑ Authorization to Construct is valid for a period equal to that of Improvement Permit – not to exceed sixty months.

Signed: Robert Adams date 6-27-07

Improvement Permit by: STEVE HEDRICK date 6-6-2007

Authorization to Construct by: STEVE HEDRICK date 3-7-08

Installed by: Robert Adams

Operation Permit by: [illegible] date 13 March 08

Existing System Inspection by: _____ date _____

HEALTH DEPT. COPY: WHITE OWNER COPY (FINAL): YELLOW OWNER COPY (INITIAL): PINK