M. Burke Paid #100 ck 2/24/94 50050

IREDELL COUNTY HEALTH DEPARTMENT

STATESVILLE 704-878-5305 MOORESVILLE 704-664-5281

IMPROVEMENT PERMIT / CERTIFICATE OF COMPLETION / OPERATION PERMIT / EXISTING SYSTEM INSPECTION

PROPERTY DESCRIPTION NO. LOVE VALLEY DATE 3/10/94 TAX MAP NO. 15D-A-58 Watershed: ☐ Yes ☑ No

OWNER OR CONTRACTOR RAYMOND E. JOHNSON PHONE: Business Home (919) 775-5328

ADDRESS 6433 DEEP RIVER ROAD SANFORD NC 27330

LOCATION LOVE VALLEY ON MITCHELL TRAIL ACROSS FROM ARENA

SUBDIVISION BLOCK / SECTION LOT LOT AREA 2.263 ACRES SITE CLASS. PS DESIGN FLOW 360 L.T.A.R. 0.4 GPD/FT²

Septic Tank: 1000 Gallons; STB 1012 Date 4/6/94

Pump Tank: Gallons; PT Date

Pump Make: Model Serial No.

Nitrification Field: No Fields 1 Square Feet 900 Linear Feet 300

No Lines 5 Trench Width 36" Max Trench Bottom Depth 18-36" Gravel Depth 12"

☑ New System ☐ Repair System Type: I, II, III, IV, V, VI

System Description: CONV. GRAVITY

Repair System Description: CONVENTIONAL PUMP

Maintenance Agreement Required: ☐ Yes ☑ No

☐ House/Mod. Home No. Bedrooms 3

☐ Mobile Home No. Bathrooms 2

☐ Business No. Employees

☐ Other


☐ Slab ☑ Crawl Space ☐ Basement w/plumbing ☐ Basement wo/plumbing

Water Supply: ☐ Individual ☐ Community ☑ Public


Comments: ① KEEP SYSTEM MINIMUM 5' FROM HOUSE, 10' FROM PROPERTY LINE, 50' FROM ANY SURFACE WATERS ② INSTALL LINES ON CONTOUR, NO DEEPER THAN 36", 9' O.C.

Comments:

INITIAL SITE SKETCH

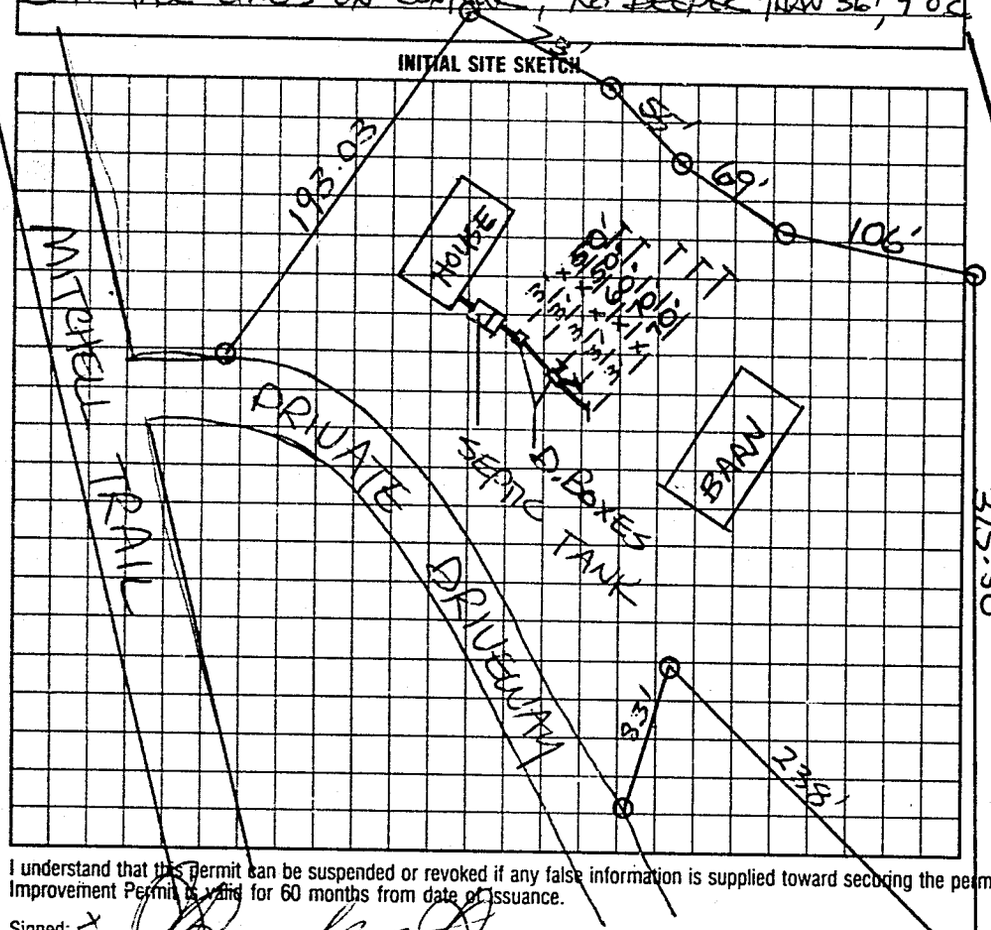

AS BUILT SKETCH

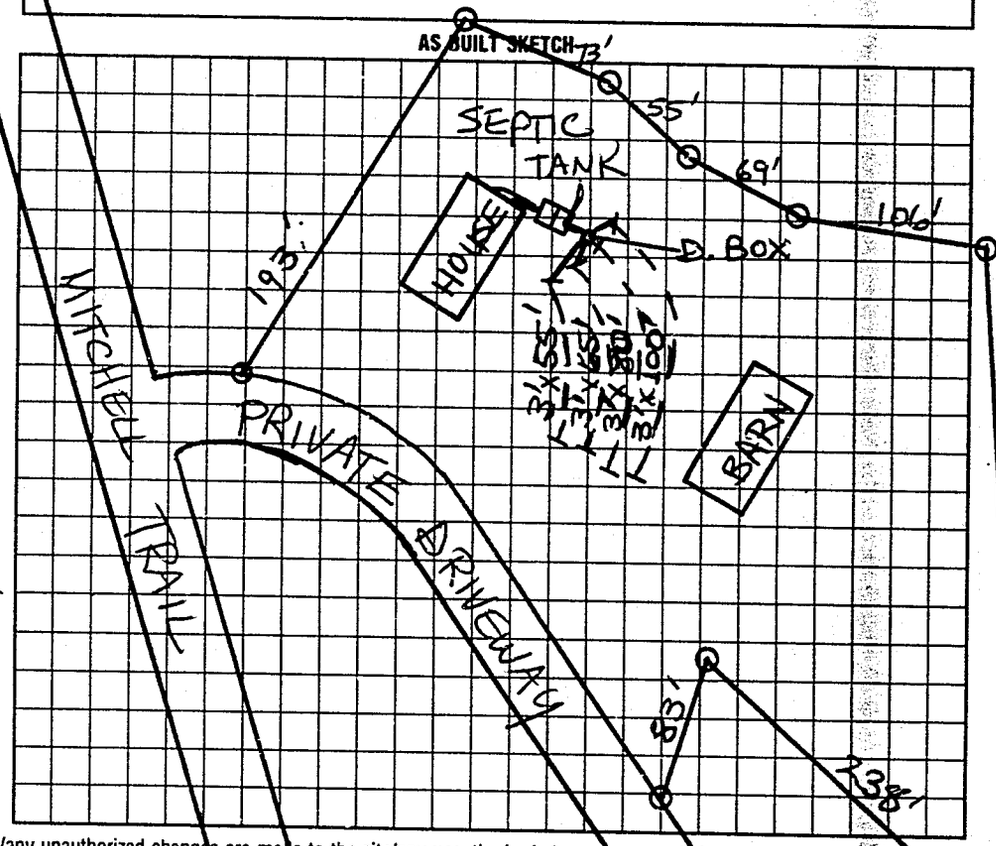

I understand that this permit can be suspended or revoked if any false information is supplied toward securing the permit/any unauthorized changes are made to the site/any unauthorized changes are made in the installation of the system. Improvement Permit is valid for 60 months from date of issuance.

Signed: X

Improvement Permit by: STEVE HEDRICK date 3/10/94

Existing System Inspection by: date

Installed by: KENNY PEARSON

Certificate of Completion by: STEVE HEDRICK date 6/30/94

Operation Permit by: date

HEALTH DEPT. COPY: WHITE INSPECTION COPY (FINAL): GREEN OWNER COPY (FINAL): YELLOW INSPECTION COPY (INITIAL): PINK OWNER COPY (INITIAL): GOLD