$125 pd. to Health dept. M.B.

IREDELL COUNTY HEALTH DEPARTMENT

STATESVILLE 704-878-5305 MOORESVILLE 704-664-5281

IMPROVEMENT PERMIT / CERTIFICATE OF COMPLETION / OPERATION PERMIT / EXISTING SYSTEM INSPECTION

PROPERTY DESCRIPTION NO. LOVE VALLEY DATE 11/28/94 TAX MAP NO. Watershed: ☐ Yes ☒ No

OWNER OR CONTRACTOR EDDIE L. WEBB PHONE: Business Home (704) 732-8938

ADDRESS 5647 OLA PLANK ROAD, IRON STATION NC 28080

LOCATION NC 115 N, TL MTN VIEW RD, TR LOVE VALLEY RD, TL MITCHELL TRAIL, ON (L) BEFORE McCARRIN TRAIL

SUBDIVISION LOVE VALLEY BLOCK / SECTION LOT 1 LOT AREA 0.494 AC SITE CLASS. PS DESIGN FLOW 240 L.T.A.R. 0.359 AC/FT

Septic Tank: 1000 Gallons; STB 1012 Date 10/18/95

Pump Tank: Gallons; PT Date

Pump Make: Model Serial No.

Nitrification Field: No Fields 1 Square Feet 690 Linear Feet 230

No Lines 3 Trench Width 36" Max Trench Bottom Depth 36" Gravel Depth 12"

☒ New System ☐ Repair System Type: I, II, III, IV, V, VI

System Description: CONVENTIONAL GRAVITY

Repair System Description: CONV. GRAVITY

Maintenance Agreement Required: ☐ Yes ☒ No

☒ House/Mod. Home ☐ Mobile Home ☐ Business ☐ Other

No. Bedrooms 1 No. Bathrooms 1 No. Employees

☐ Slab ☒ Crawl Space ☐ Basement w/plumbing ☐ Basement wo/plumbing


Water Supply: ☐ Individual ☐ Community ☒ Public

Comments: (1) KEEP SYSTEM MINIMUM 10' FROM PROPERTY LINE, 5' FROM HOUSE, 10' FROM WATER LINE (2) INSTALL LINES AS SHOWN ON CONTOUR, NO DEEPER THAN 36", 9' MINIMUM APART ON CENTER

Comments: Septic fee paid to Health Dept. #125

1 BACK OFF RD ~ 500'

INITIAL SITE SKETCH

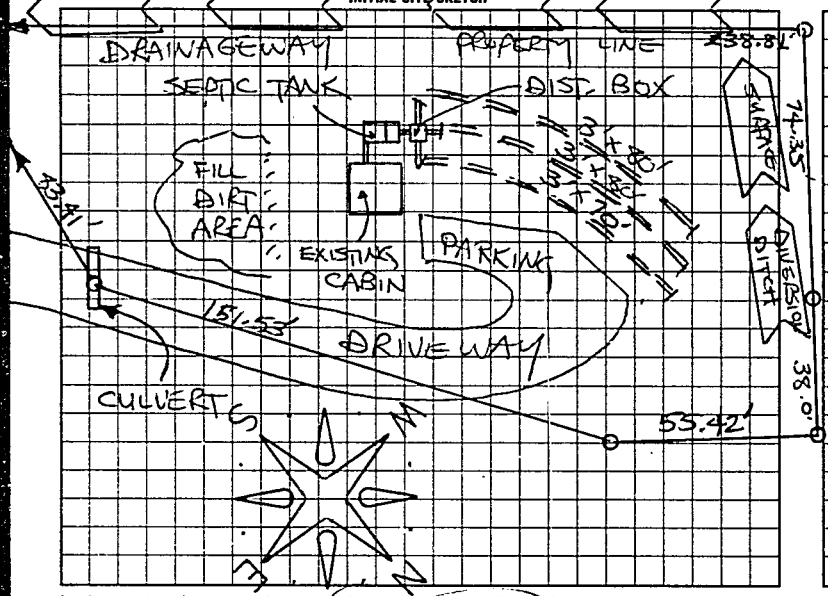

AS BUILT SKETCH

SYSTEM INSTALLED ACCORDING TO INITIAL SITE SKETCH

I understand that this permit can be suspended or revoked if any false information is supplied toward securing the permit/any unauthorized changes are made to the site/any unauthorized changes are made in the installation of the system. Improvement Permit is valid for 60 months from date of issuance.

Signed:

Improvement Permit by: STEVE HEDRICK date 11/28/94

Existing System Inspection by: date

Installed by: KENNY PEARSON

Certificate of Completion by: STEVE HEDRICK date 1/26/95

Operation Permit by: date

HEALTH DEPT. COPY: WHITE INSPECTION COPY (FINAL): GREEN OWNER COPY (FINAL): YELLOW INSPECTION COPY (INITIAL): PINK OWNER COPY (INITIAL): GOLD

0 0 2 2 2 4