IREDELL COUNTY HEALTH DEPARTMENT

STATESVILLE 704-878-5305 MOORESVILLE 704-664-5281

IMPROVEMENT PERMIT / AUTHORIZATION TO CONSTRUCT / OPERATION PERMIT / EXISTING SYSTEM INSPECTION

PERMIT# LOVE VALLEY PIN#

OWNER OR CONTRACTOR CALVIN M. THOMAS PHONE: Business Home (704) 857-8132 DATE 4-8-98

ADDRESS 380 WADE DRIVE, CHINA GROVE NC 28023

LOCATION NC 115 N, TL MTN. VIEW ROAD, TR LOVE VALLEY ROAD, TL MITCHELL TRAIL, ON LEFT AT RESTAURANT

SUBDIVISION BLOCK / SECTION LOT LOT AREA 0.383 ACRE SITE CLASS PS DESIGN FLOW 240 L.T.A.R. 0.33 GPD/FT²

Septic Tank: 1000 Gallons; STB 100F Date 5-14-98

Pump Tank: Gallons; PT Date

Pump Make: Model Serial No.

Nitrification Field: No Fields 1 Square Feet 60 @ 720 Linear Feet 120'

No Lines FOUR Trench Width 24" Max Trench Bottom Depth 36" Gravel Depth 6" SAND

☑ New System ☐ Repair System Type: I, II, III, IV, V, VI

System Description: PPBPS GRAVITY

Repair System Description: PPBPS GRAVITY

Maintenance Agreement Required: ☐ Yes ☑ No

☑ House/Mod. Home No. Bedrooms 1

☐ Mobile Home No. Bathrooms 2

☐ Business No. Employees

☐ Other


☐ Slab ☑ Crawl Space ☐ Basement w/plumbing ☐ Basement wo/plumbing

Water Supply: ☐ Individual ☑ Public ☐ Community


Comments:/Conditions: ① USE THREE FLOW DIVIDER TEES TO ACHIEVE EQUAL DISTRIBUTION INTO EACH OF FOUR 30' LINES ② INSTALL TWENTY-EIGHT (28) PPBPS PANELS IN FOUR EQUAL LENGTH LINES AT SEVEN (7) PER LINE.

Comments:/Conditions: * Note Cutoff & Drain lines from Neighboring Restaurant

INITIAL SITE SKETCH P.L - 123.35' SCALE: 1" = 30'

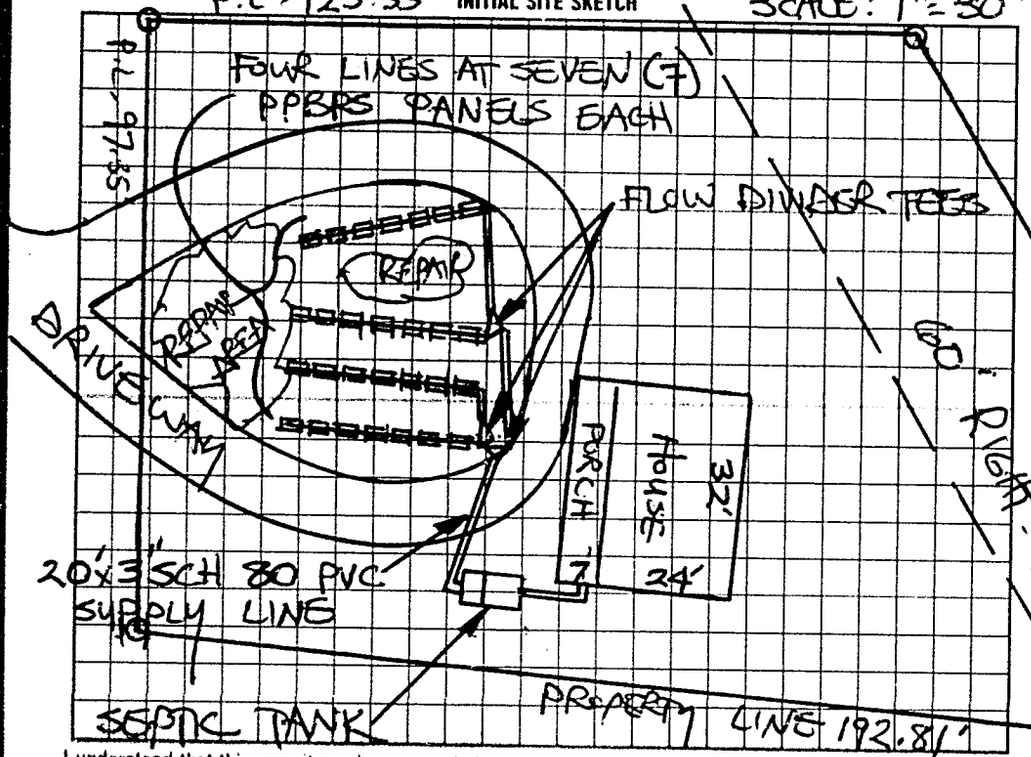

AS BUILT SKETCH

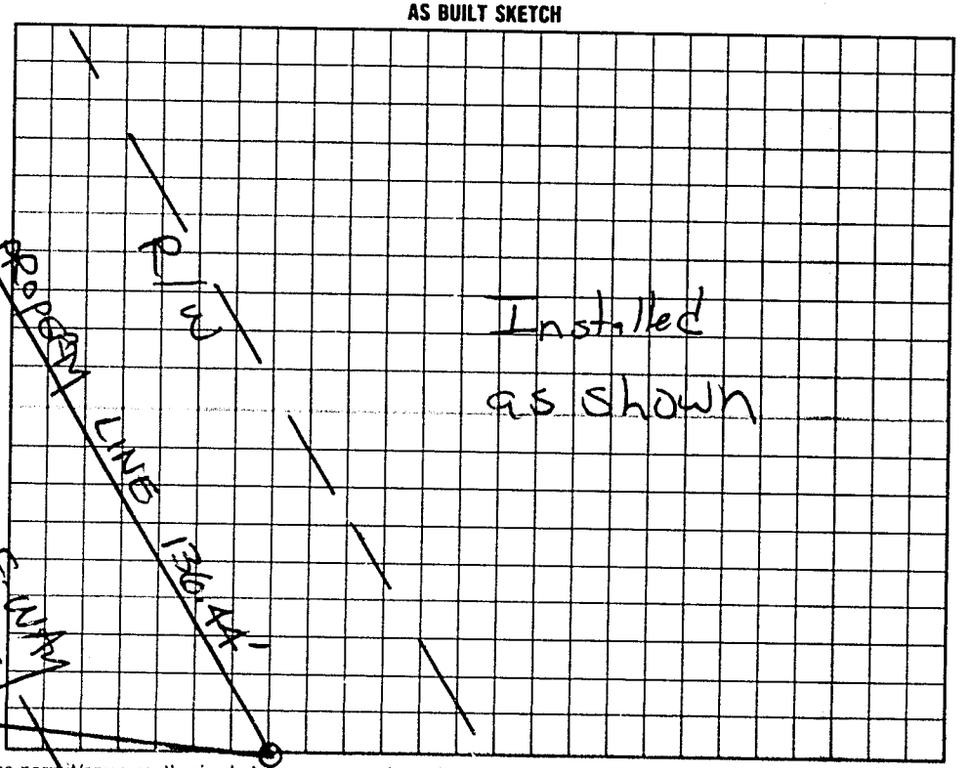

I understand that this permit can be suspended or revoked if any false information is supplied toward securing the permit/any unauthorized changes are made to the site/any unauthorized changes are made in the installation of the system. Improvement Permit with plat valid without expiration. Improvement Permit with site plan valid for sixty months. Authorization to Construct is valid for a period equal to that of Improvement Permit – not to exceed sixty months.

Signed: X C M Thomas date 4-8-98

Improvement Permit by: STEVE HENDRICK date 4-8-98

Authorization to Construct by: STEVE HENDRICK date 4-8-98

Installed by: Berry Sigmon

Operation Permit by: MayCO of BS date 6-23-98

Existing System Inspection by: date

HEALTH DEPT. COPY: WHITE INSPECTION COPY (FINAL): GREEN OWNER COPY (FINAL): YELLOW INSPECTION COPY (INITIAL): PINK OWNER COPY (INITIAL): GOLD

895000