07/638

IREDELL COUNTY HEALTH DEPARTMENT

THIS PERMIT VOIDS PREVIOUS ISSUED 12-19-97

STATESVILLE 704-878-5305 MOORESVILLE 704-664-5281 paid $250.00

IMPROVEMENT PERMIT / AUTHORIZATION TO CONSTRUCT / OPERATION PERMIT / EXISTING SYSTEM INSPECTION

PERMIT# LOVE VALLEY PIN# DATE 9-21-98

OWNER OR CONTRACTOR RICHARD HUNTER PHONE: Business 361-8180 (m) Home 732-0975

ADDRESS 6437 TOPAZ LANE, IRON STATION NC 28080

LOCATION NC115N, TL MTN. VIEW, TR LOVE VALLEY, TL MITCHELL, TR McCARRON, TL GRIER PASS (AT Box #161)

SUBDIVISION _____ BLOCK / SECTION _____ LOT 36 LOT AREA LIMITED SITE CLASS PS DESIGN FLOW 240 L.T.A.R. 0.50 GPD/FT²

Septic Tank: 1000 Gallons; STB 1017 Date 2-17-99
Pump Tank: _____ Gallons; PT _____ Date _____
Pump Make: _____ Model _____ Serial No. _____
Nitrification Field: No Fields 1 Square Feet EQ TO 480 Linear Feet 120
No Lines FOUR Trench Width 36" Max Trench Bottom Depth 36" Gravel Depth SAND 6"

☑ New System ☐ Repair System Type: I, II, (III), IV, V, VI
System Description: 25% REDUCTION GRAVITY
Repair System Description: MAXIMUM FEASIBLE
Maintenance Agreement Required: ☐ Yes ☑ No

☑ House/Mod. Home No. Bedrooms 3
☐ Mobile Home No. Bathrooms 2
☐ Business No. Employees ____
☐ Other _____


☐ Slab ☐ Crawl Space ☐ Basement w/plumbing ☑ Basement wo/plumbing

Water Supply: ☑ Individual ☐ Public ☐ Community
WELL


Comments:/Conditions: ① INSTALL 25% REDUCTION SYSTEM ON CONTOUR AS SHOWN USING TWENTY CHAMBERS OR TWELVE HDS SECTIONS ② KEEP SYSTEM MAXIMUM FEASIBLE DISTANCE NO LESS THAN 50' FROM WELL

Comments:/Conditions:

INITIAL SITE SKETCH SCALE: 1" = 30'

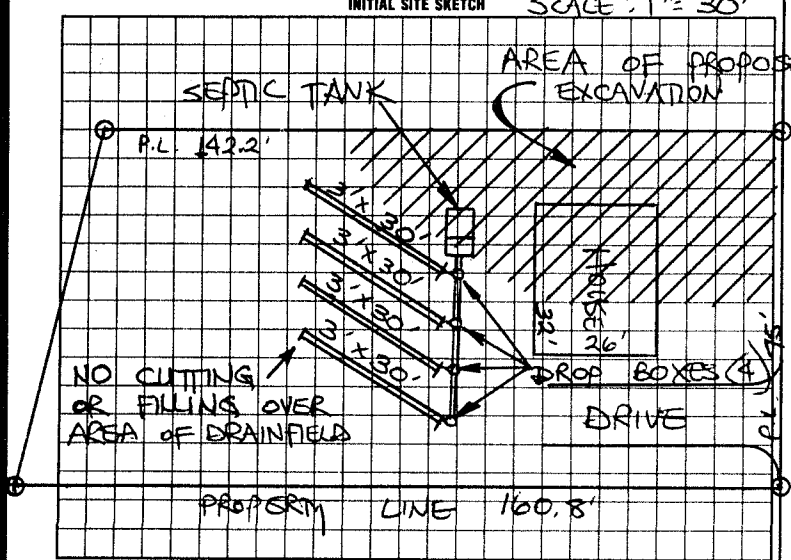

AS BUILT SKETCH

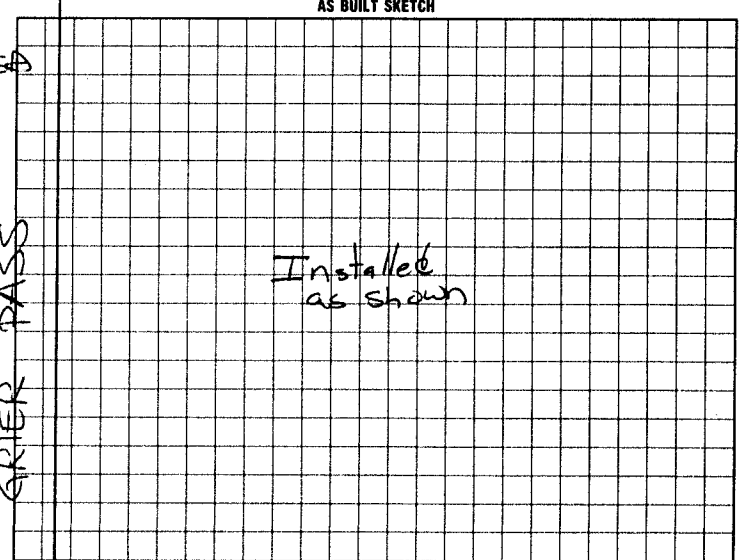

I understand that this permit can be suspended or revoked if any false information is supplied toward securing the permit/any unauthorized changes are made to the site/any unauthorized changes are made in the installation of the system. Improvement Permit with plat valid without expiration. Improvement Permit with site plan valid for sixty months. Authorization to Construct is valid for a period equal to that of Improvement Permit – not to exceed sixty months.

Signed: Richard Hunter date 9-21-98 Installed by: C+W Septic

Improvement Permit by: STEVE HEDRICK date 9-21-98 Operation Permit by: [illegible] date 4-7-99

Authorization to Construct by: STEVE HEDRICK date 9-21-98 Existing System Inspection by: _____ date _____

HEALTH DEPT. COPY: WHITE INSPECTION COPY (FINAL) GREEN OWNER COPY (FINAL) YELLOW INSPECTION COPY (INITIAL) PINK OWNER COPY (INITIAL) GOLD