IREDELL COUNTY HEALTH DEPARTMENT

STATESVILLE 704-878-5305 MOORESVILLE 704-664-5281

IMPROVEMENT PERMIT / AUTHORIZATION TO CONSTRUCT / OPERATION PERMIT / EXISTING SYSTEM INSPECTION

PERMIT# REPAIR PIN#

OWNER OR CONTRACTOR BARBARA WARREN PHONE: Business Home 828-63 DATE 12-30-98

ADDRESS 173 McCARRIN TRAIL, STATESVILLE, NC 28625

LOCATION NC 115 N, TL MTN. VIEW, TR LOVE VALLEY, TL MITCHELL, TR McCARRIN ON LEFT

SUBDIVISION BLOCK / SECTION LOT LOT AREA LIMITED SITE CLASS. PS DESIGN FLOW 240 L.T.A.R. EXISTING

Septic Tank: 1000 Gallons; STB 1012 Date 10-18-98
Pump Tank: Gallons; PT Date
Pump Make: Model Serial No.
Nitrification Field: No Fields 1 Square Feet 420 Linear Feet 70
No Lines 1 BEC Trench Width 72" Max Trench Bottom Depth 36"± Gravel Depth (24")

[X] New System [X] Repair System Type: [I], II, III, IV, V, VI
System Description: CONV. GRAVITY
Repair System Description: CONV. GRAVITY
Maintenance Agreement Required: [ ] Yes [X] No

[ ] House/Mod. Home No. Bedrooms 2
[ ] Mobile Home No. Bathrooms 1
[ ] Business No. Employees
[ ] Other
[ ] Slab [X] Crawl Space [ ] Basement w/plumbing [ ] Basement wo/plumbing


Water Supply: [ ] Individual [X] Public [ ] Community

Comments:/Conditions: THIS PERMIT SERVES AS NOTICE OF VIOLATION

Comments:/Conditions:

PAST LONG BARN

INITIAL SITE SKETCH ~SCALE: 1"=40'

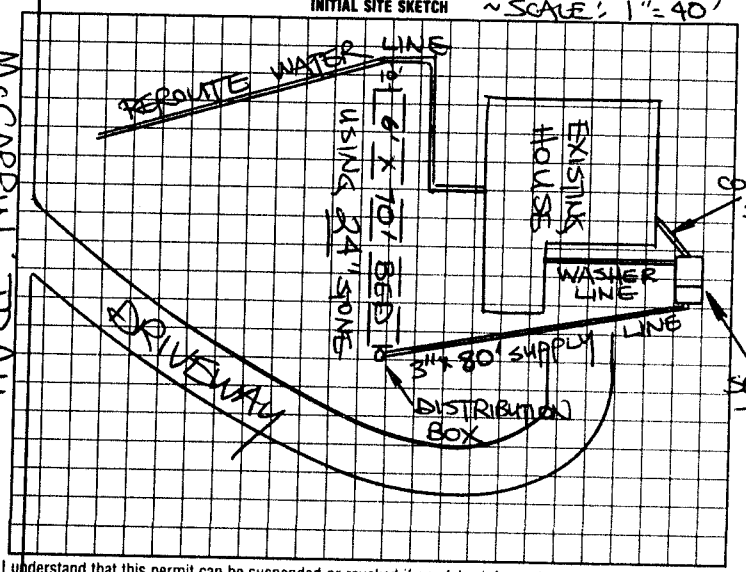

AS BUILT SKETCH

SYSTEM REPAIRED ACCORDING TO INITIAL SITE SKETCH

I understand that this permit can be suspended or revoked if any false information is supplied toward securing the permit/any unauthorized changes are made to the site/any unauthorized changes are made in the installation of the system. Improvement Permit with plat valid without expiration. Improvement Permit with site plan valid for sixty months. Authorization to Construct is valid for a period equal to that of Improvement Permit – not to exceed sixty months.

Signed: + Barbara L Warren date 12-30-98 Installed by: DALE FOX

Improvement Permit by: STEVE HEDRICK date 12-30-98 Operation Permit by: STEVE HEDRICK date 2-5-99

Authorization to Construct by: STEVE HEDRICK date 12-30-98 Existing System Inspection by: date

HEALTH DEPT. COPY: WHITE INSPECTION COPY (FINAL): GREEN OWNER COPY (FINAL): YELLOW INSPECTION COPY (INITIAL): PINK OWNER COPY (INITIAL): GOLD