IREDELL COUNTY HEALTH DEPARTMENT

STATESVILLE 704-878-5305 MOORESVILLE 704-664-5281

IMPROVEMENT PERMIT / CERTIFICATE OF COMPLETION / OPERATION PERMIT / EXISTING SYSTEM INSPECTION

PROPERTY DESCRIPTION NO. TOWN OF LOVE VALLEY DATE 6/7/93 TAX MAP NO. 15D-2-J-1

OWNER OR CONTRACTOR MICHAEL WAYNE HARMON PHONE: Business Home (704) 798-3909

ADDRESS RT. 19 BOX 173A LEXINGTON NC 27292

LOCATION NC115N, TL MTN VIEW ROAD, TR LOVE VALLEY RD, TL MITCHELL TRAIL, TR McCARRON TRAIL, 0.4 MI on R

SUBDIVISION BLOCK / SECTION LOT LOT AREA ~1 ACRE SITE CLASS. PS L.T.A.R.

Water Supply: ☐ Individual ☐ Community ☐ Public NO WATER SUPPLY

Septic Tank: Gallons; STB Date

Pump Tank: Gallons; PT Date

Nitrification Field: No Fields Square Feet Linear Feet

No Lines Trench Width 42" Trench Depth 6' Gravel Depth

☑ New System ☐ Repair System Type I, II, IV, V, VI

System Description: PIT PRIVY

Repair System Description: CONV.

Maintenance Agreement Required: ☐ Yes ☑ No

☐ House/Mod. Home ☐ Mobile Home ☐ Business ☑ Other CAMPER


No. Bedrooms 1 No. Bathrooms N/A No. Employees

Garbage Disposal: ☐ Yes ☑ No Auto. Dishwasher: ☐ Yes ☑ No Auto. Washing Machine: ☐ Yes ☑ No Other


☐ Slab ☑ Crawl Space ☐ Basement w/plumbing ☐ Basement wo/plumbing

Comments INFORMATION SUPPLIED CONCERNING MAINTENANCE OF PIT PRIVY

INITIAL SITE SKETCH

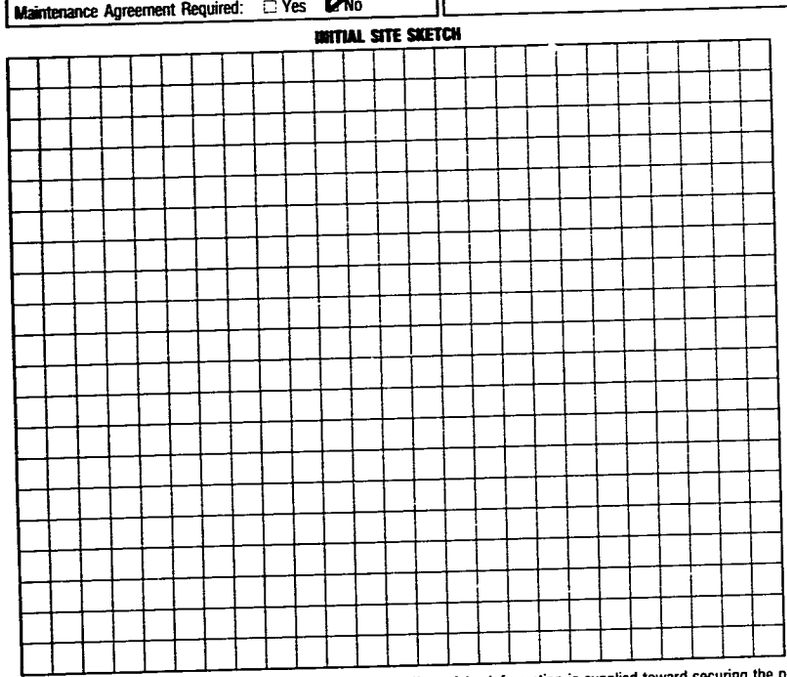

AS BUILT SKETCH

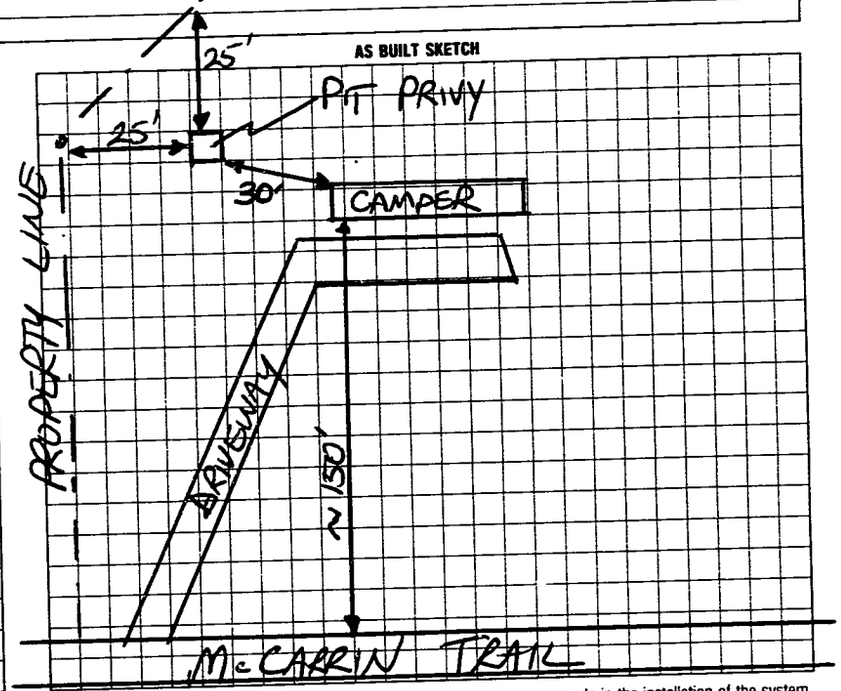

I understand that this permit can be suspended or revoked if any false information is supplied toward securing the permit/any unauthorized changes are made to the site/any unauthorized changes are made in the installation of the system. Improvement Permit is valid for 60 months from date of issuance.

Signed:

Improvement Permit by: STEVE HEDRICK date 6/9/92

Existing System Inspection by: date

Installed by: MICHAEL WAYNE HARMON

Certificate of Completion by: STEVE HEDRICK date 6/7/93

Operation Permit by: STEVE HEDRICK date 6/7/93

HEALTH DEPT. COPY: WHITE INSPECTION COPY (FINAL): GREEN OWNER COPY (FINAL): YELLOW INSPECTION COPY (INITIAL): PINK OWNER COPY (INITIAL): GOLD