4812-31-4171 252-638-1114

IREDELL COUNTY HEALTH DEPARTMENT

STATESVILLE 704-878-5305 MOORESVILLE 704-664-5281

IMPROVEMENT PERMIT / AUTHORIZATION TO CONSTRUCT / OPERATION PERMIT / EXISTING SYSTEM INSPECTION

PERMIT# 103734 PIN# ~~4812-30-4171~~ / ~~5961~~ / ~~4945~~ DATE 1-30-02

OWNER OR CONTRACTOR ANDY BARKER PHONE: Business 704-592-7451 Home 252-638-1901

ADDRESS 169 HENRY MARTIN TRAIL, STATESVILLE, NC 28625

LOCATION NC 115 N, TL MTN. VIEW RD, TR LOVE VALLEY RD TL MITCHELL, TR McCARRON, 0.3 MILE ON LEFT

SUBDIVISION LOVE VALLEY BLOCK / SECTION ____ LOT ~~SIZE 22.9610 AC~~ LOT AREA 0.9610 ACRE SITE CLASS. PS DESIGN FLOW 240 L.T.A.R. 0.40 GPD/FT²

Septic Tank: 1000 Gallons; STB 825 Date 5-20-04
Pump Tank: ____ Gallons; PT ____ Date ____
Pump Make: ____ Model ____ Serial No. ____
Nitrification Field: No Fields 1 Square Feet 600 Linear Feet 200
No Lines TWO Trench Width 36" Max Trench Bottom Depth 32-36 Gravel Depth 12"

☑ New System ☐ Repair System Type: I, II, III, IV, V, VI
System Description: CONVENTIONAL, GRAVITY
Repair System Description: CONVENTIONAL, GRAVITY
Maintenance Agreement Required: ☐ Yes ☑ No


☑ House/Mod. Home No. Bedrooms 3
☐ Mobile Home No. Bathrooms 2
☐ Business No. Employees ____
☐ Other ____
☐ Slab ☑ Crawl Space ☐ Basement w/plumbing ☐ Basement wo/plumbing

Water Supply: ☐ Individual ☑ Public ☐ Community

Comments:/Conditions: INSTALL LINES AT LEAST 32" DEEP AS FLAGGED ON SITE

Comments:/Conditions: SEPTIC TANK WITH MARKER INSTALLED USING "PolyLok" FILTER

INITIAL SITE SKETCH

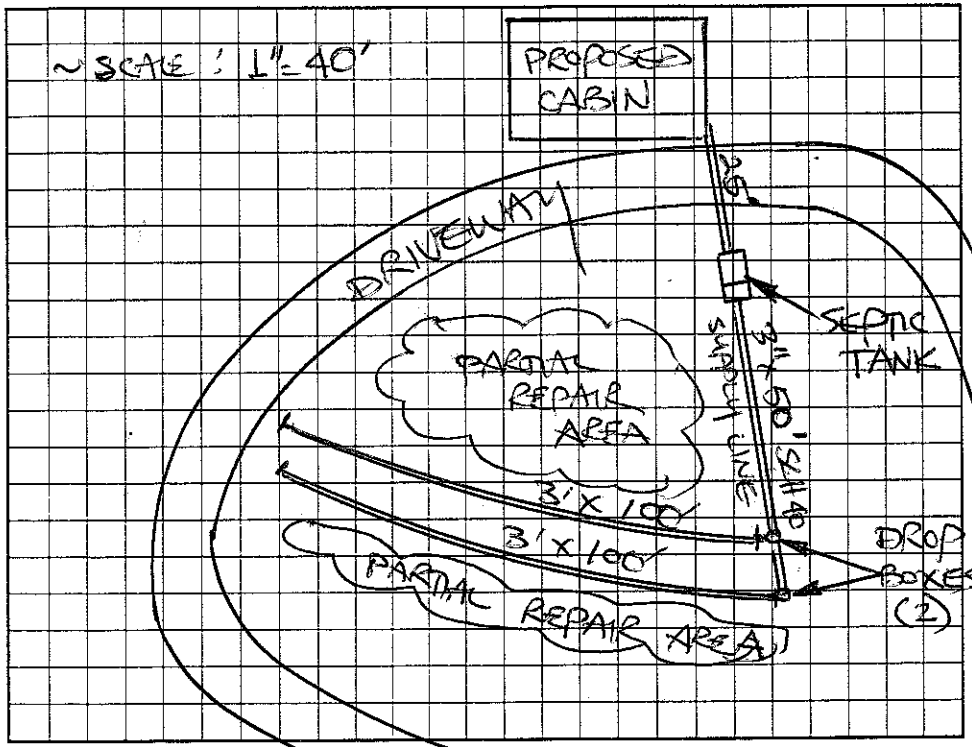

AS BUILT SKETCH

SYSTEM INSTALLED ACCORDING TO INITAL SITE SKETCH

Permit can be suspended or revoked if any false information is supplied toward securing the permit/any unauthorized changes are made to the site/any unauthorized changes are made in the installation of the system. Improvement Permit with plat valid without expiration. Improvement Permit with site plan valid for sixty months. Authorization to Construct is valid for a period equal to that of Improvement Permit – not to exceed sixty months.

Signed: Ellenora S Barker date 1-30-02 Installed by: ANDY DANIELS

Improvement Permit by: STEVE HEDRICK date 1-30-02 Operation Permit by: STEVE HEDRICK date 7-21-04

Authorization to Construct by: STEVE HEDRICK date 1-30-02 Existing System Inspection by: ____ date ____

HEALTH DEPT. COPY: WHITE OWNER COPY (FINAL): YELLOW OWNER COPY (INITIAL): PINK