IREDELL COUNTY HEALTH DEPARTMENT

STATESVILLE 704-878-5305 (C1) MOORESVILLE 704-664-5281

IMPROVEMENT PERMIT / AUTHORIZATION TO CONSTRUCT / OPERATION PERMIT / EXISTING SYSTEM INSPECTION

PERMIT# 112890 PIN# 4812-38-1078 DATE 6-3-03

OWNER OR CONTRACTOR CHARLES A. JOHNSON PHONE: Business 704-902-0195 Home 704-592-2378

ADDRESS 532 COOLBROOK ROAD UNION GROVE, NC 28689

LOCATION NC 115 NORTH, TL COOLBROOK ROAD, 1.7 MILES ON RIGHT AT BOX # 532, 650' BACK OFF ROAD

SUBDIVISION _____ BLOCK / SECTION _____ LOT _____ LOT AREA 3.79 ACRES SITE CLASS. PS DESIGN FLOW 480' L.T.A.R. 0.30 GPD/FT²

Septic Tank: EXISTING Gallons: STB _____ Date _____

Pump Tank: _____ Gallons: PT _____ Date _____

Pump Make: _____ Model _____ Serial No. _____

Nitrification Field: No Fields 1 Square Feet EQ. TO 400 Linear Feet 100

No Lines TWO Trench Width 36" Max Trench Bottom Depth 36" Gravel Depth N/A

☑ New System ☐ Repair System Type: I, II, (III), IV, V, VI

System Description: 25% REDUCTION, GRAVITY

Repair System Description: 25% REDUCTION, PUMP

Maintenance Agreement Required: ☐ Yes ☑ No

☐ House/Mod. Home ☑ Mobile Home ☐ Business ☐ Other

No. Bedrooms 4 No. Bathrooms 2 No. Employees _____


☐ Slab ☑ Crawl Space ☐ Basement w/plumbing ☐ Basement wo/plumbing

Water Supply: ☐ Individual ☐ Public ☐ Community


Comments:/Conditions: EXPAND SYSTEM AS SHOWN BY USING TWO NEW DROP BOXES FEEDING 25% REDUCTION SYSTEM ON CONTOUR

Comments:/Conditions:

PROPERTY LINE ~700' INITIAL SITE SKETCH

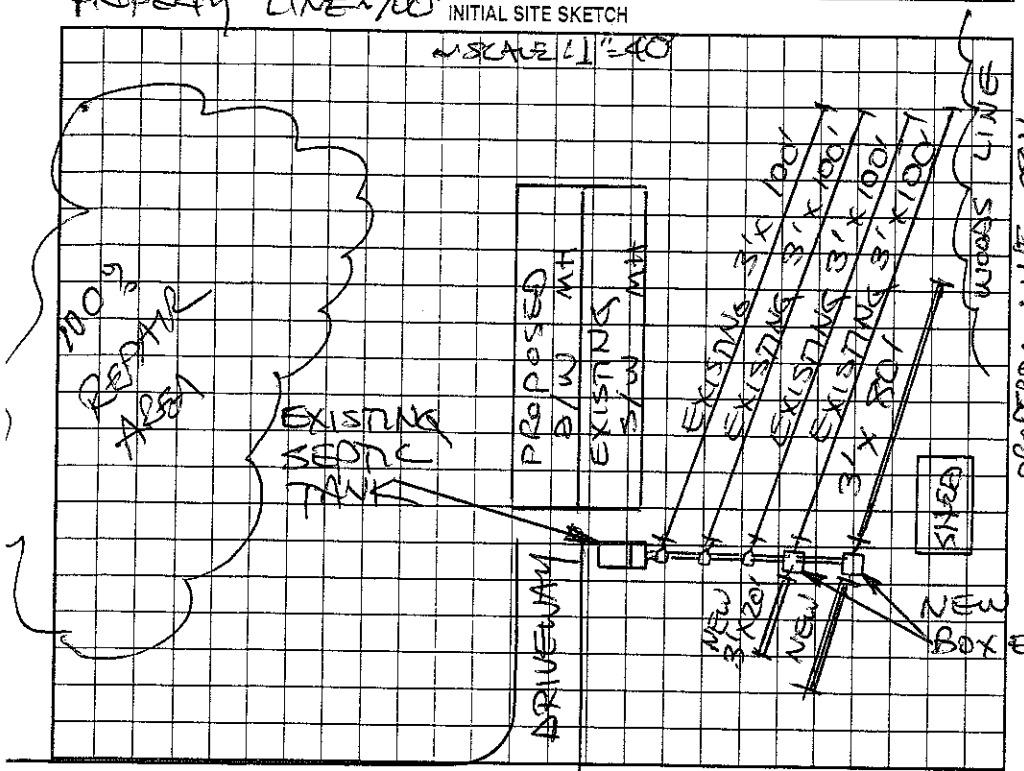

AS BUILT SKETCH

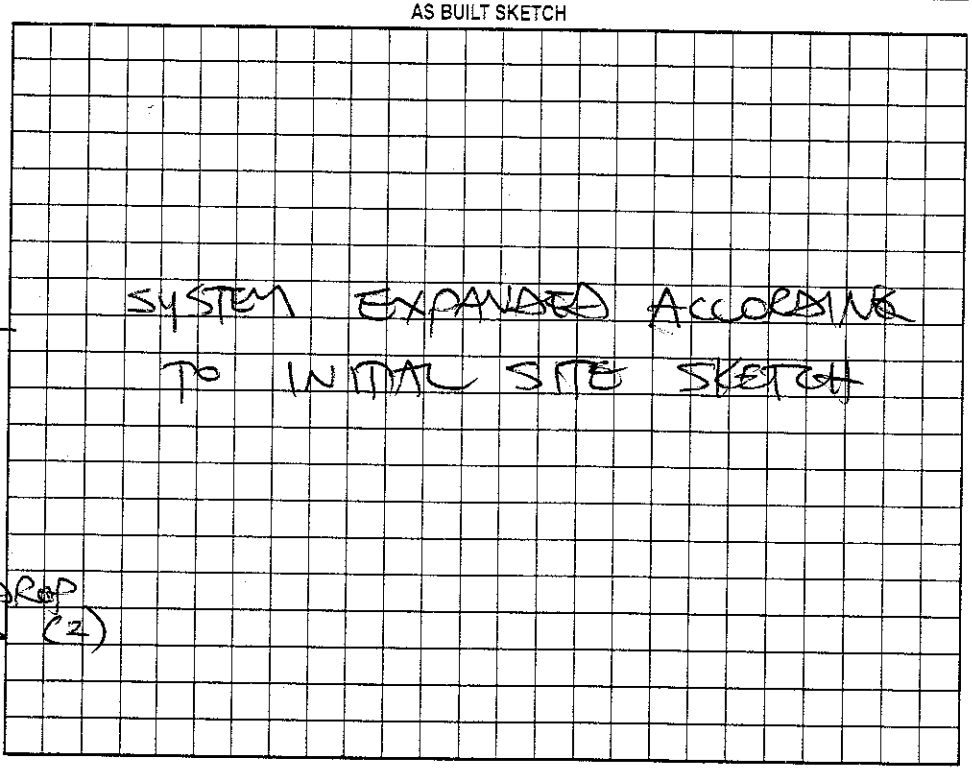

Permit can be suspended or revoked if any false information is supplied toward securing the permit/any unauthorized changes are made to the site/any unauthorized changes are made in the installation of the system. Improvement Permit with plat valid without expiration. Improvement Permit with site plan valid for sixty months. Authorization to Construct is valid for a period equal to that of Improvement Permit – not to exceed sixty months.

Signed: Charles Johnson date 6-4-03

Improvement Permit by: STEVE HEDRICK date 6-3-03

Authorization to Construct by: STEVE HEDRICK date 6-3-03

Installed by: ANDY DANIELS

Operation Permit by: STEVE HEDRICK date 6-26-03

Existing System Inspection by: _____ date _____

HEALTH DEPT. COPY: WHITE OWNER COPY (FINAL): YELLOW OWNER COPY (INITIAL): PINK