IREDELL COUNTY HEALTH DEPARTMENT

STATESVILLE 704-878-5305 MOORESVILLE 704-664-5281

IMPROVEMENT PERMIT / CERTIFICATE OF COMPLETION / OPERATION PERMIT / EXISTING SYSTEM INSPECTI

PROPERTY DESCRIPTION NO. 066130 DATE 5-6-97 TAX MAP NO. 4891 23 8 10 38 78 Watershed: ☐ Yes

OWNER OR CONTRACTOR CHARLES JOHNSON, JR PHONE: Business Home 876-1043

ADDRESS 181 BLUEGILL LANE STATESVILLE, NC 28677

LOCATION NC 115 N, TL COOLBROOK ROAD, 1.7 MILES ON RIGHT, ~ 650' BACK OFF R

SUBDIVISION BLOCK / SECTION LOT LOT AREA 3.79 ACRES SITE CLASS. P5 DESIGN FLOW 360 L.T.A.R. 0.30 GPD

Septic Tank: 1000 Gallons; STB 794 Date 3-11-97

Pump Tank: Gallons; PT Date

Pump Make: Model Serial No.

Nitrification Field: No Fields 1 Square Feet 1200 Linear Feet 400

No Lines FOUR Trench Width 36" Max Trench Bottom Depth 36" Gravel Depth 12"

☒ New System ☐ Repair System Type: ☒ I, II, III, IV, V, VI

System Description: CONVENTIONAL SYSTEM

Repair System Description: CONV. S&V/PUMP

Maintenance Agreement Required: ☐ Yes ☒ No

☐ House/Mod. Home No. Bedrooms 3

☐ Mobile Home No. Bathrooms 2

☐ Business No. Employees

☐ Other


☐ Slab ☒ Crawl Space ☐ Basement w/plumbing ☐ Basement wo/plumbing

Water Sup ☒ Individ ☐ Commu ☐ Public WELL


Comments:

Comments:

INITIAL SITE SKETCH

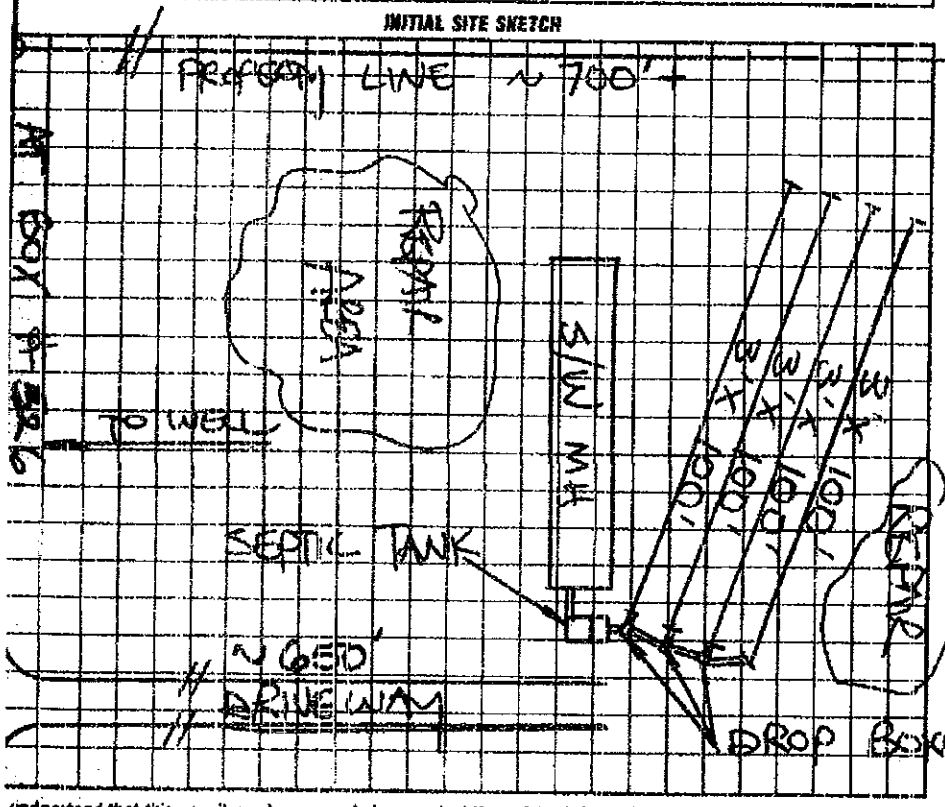

AS BUILT SKETCH

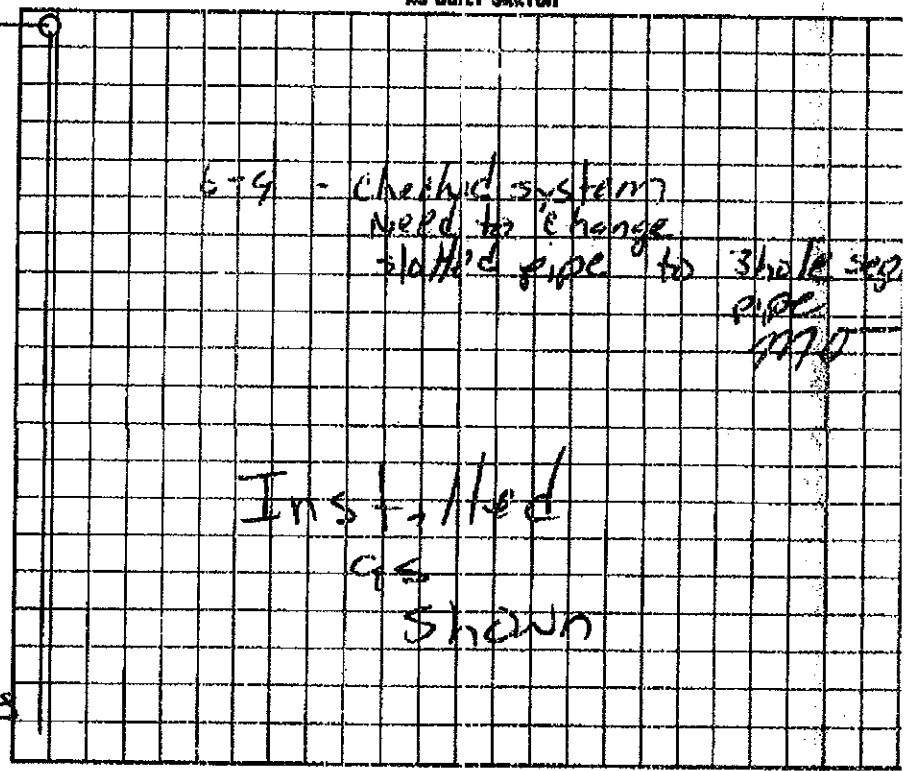

I understand that this permit can be suspended or revoked if any false information is supplied toward securing the permit/any unauthorized changes are made to the site/any unauthorized changes are made in the installation of the syst Improvement Permit is valid for 60 months from date of issuance. AUTHORIZATION TO CONSTRUCT IS VALID FOR 60 MONTHS FROM DATE OF ISSU

Signed: Charles Johnson Jr

Improvement Permit by: STEVE HEDRICK date 5-6-97

Installed by: Charles Johnson

Certificate of Completion by: date

Existing System Inspection by: STEVE HEDRICK date 5-6-97

Operation Permit by: date 6-12-

HEALTH DEPT COPY WHITE INSPECTION COPY (FINAL) GREEN OWNER COPY (FINAL) YELLOW INSPECTION COPY (INITIAL) PINK OWNER COPY (INITIAL) GOLD

MAY. 25, 19:5 20:41