400 EXISTING

IREDELL COUNTY HEALTH DEPARTMENT

THIS PERMIT VOIDS P.D.# 24233 ISSUED 6-19-96 6/863

STATESVILLE 704-878-5305 MOORESVILLE 704-664-5281

IMPROVEMENT PERMIT / CERTIFICATE OF COMPLETION / OPERATION PERMIT / EXISTING SYSTEM INSPECTION

PROPERTY DESCRIPTION NO. 24253 DATE 6-24-96 TAX MAP NO. 15D - A-8 Watershed: ☐ Yes ☒ No

OWNER OR CONTRACTOR WALTER SHEPHERD PHONE: Business Home 592-4816

ADDRESS 444 COOLBROOK RD UNION GROVE, NC 28689

LOCATION NC 115 N, TL COOLBROOK ROAD, 1.7 MILES ON RIGHT AT BOX #444

SUBDIVISION BLOCK / SECTION LOT LOT AREA 37.27 AC SITE CLASS. PS DESIGN FLOW 240 L.T.A.R. 0.30 GPD/FT²

Septic Tank: 1000 Gallons; STB 862 Date 2-17-97

Pump Tank: Gallons; PT Date

Pump Make: Model Serial No.

Nitrification Field: No Fields 1 Square Feet 810 Linear Feet 270

No Lines 3 Trench Width 36" Max Trench Bottom Depth 30" Gravel Depth 12"

☒ New System ☐ Repair System Type: I, II, III, IV, V, VI

System Description: CONV. GRAVITY

Repair System Description: CONV. GRAVITY

Maintenance Agreement Required: ☐ Yes ☒ No

☒ House/Mod. Home No. Bedrooms 1

☐ Mobile Home BARN No. Bathrooms 1

☐ Business No. Employees

☐ Other


☒ Slab ☐ Crawl Space ☐ Basement w/plumbing ☐ Basement wo/plumbing

Water Supply: ☒ Individual ☐ Community ☐ Public WELL


Comments: ① INSTALL SUBSURFACE INTERCEPT DRAIN AS SHOWN, MINIMUM 10' FROM DRAINFIELD, BEGINNING 4' DEEP FALLING OUT TO DAYLIGHT ② INSTALL DRAINLINES ON CONTOUR, AS PLACED, NO DEEPER THAN 30"

Comments:

INITIAL SITE SKETCH

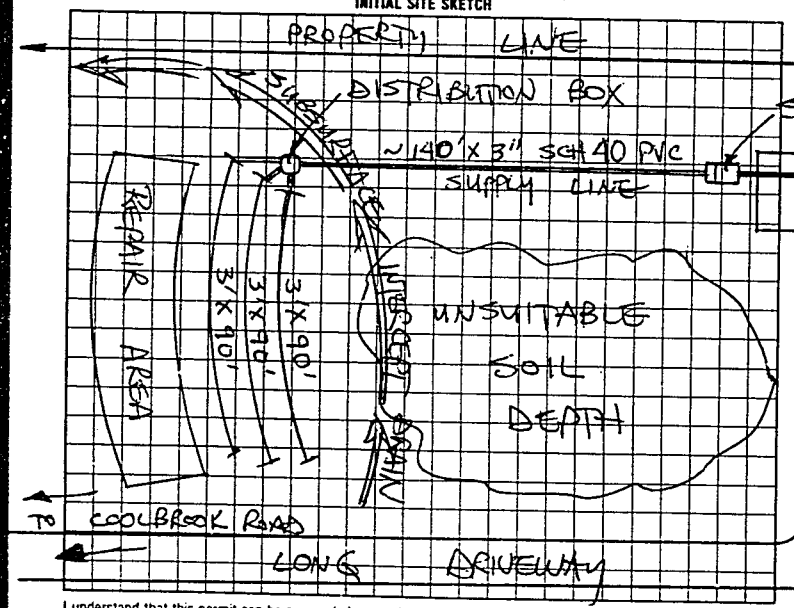

AS BUILT SKETCH

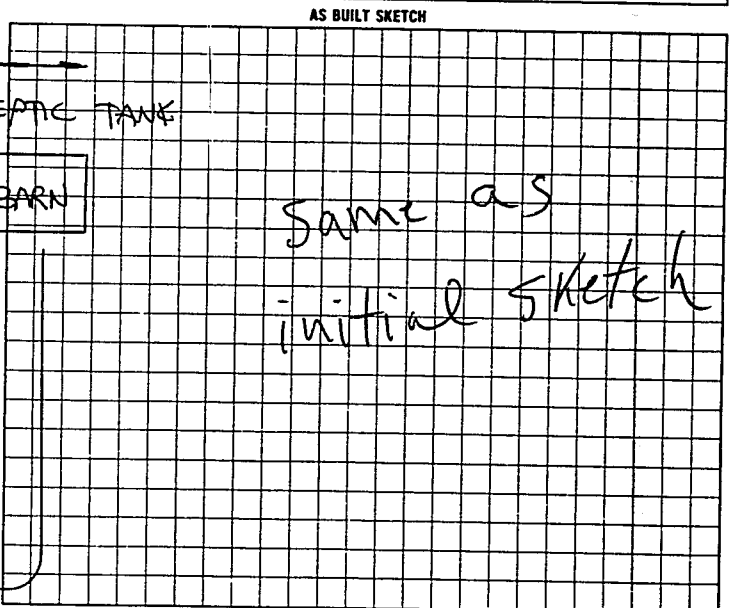

I understand that this permit can be suspended or revoked if any false information is supplied toward securing the permit/any unauthorized changes are made to the site/any unauthorized changes are made in the installation of the system. Authorization to Construct is valid five (5) years from date of issuance. Improvement Permit has no expiration date.

Signed: Walter Shepherd

Improvement Permit by: STEVE HERRICK date 6-24-96

AUTHORIZATION TO CONSTRUCT: STEVE HERRICK date 6-24-96

Installed by: James Hurtle

Certificate of Completion by: date

Operation Permit by: L. C. Moore date 3-25-97

HEALTH DEPT COPY WHITE INSPECTION COPY (FINAL) GREEN OWNER COPY (FINAL) YELLOW INSPECTION COPY (INITIAL) PINK OWNER COPY (INITIAL) GOLD