IREDELL COUNTY HEALTH DEPARTMENT

STATESVILLE 704-878-5305 MOORESVILLE 704-664-5281

IMPROVEMENT PERMIT / AUTHORIZATION TO CONSTRUCT / OPERATION PERMIT / EXISTING SYSTEM INSPECTION

PERMIT# 100732 PIN# 4812 57 0250 DATE 6-8-01

OWNER OR CONTRACTOR WALTER SHEPHERD PHONE: Business Home (704) 592-4816

ADDRESS 444 COOLBROOK ROAD UNION GROVE, NC 28689

LOCATION NC 115 N, TL COOLBROOK ROAD, ON RIGHT AT BOX # 444, BACK OFF ROAD

SUBDIVISION BLOCK / SECTION LOT LOT AREA 37.27 ACRES SITE CLASS PS DESIGN FLOW 360 L.T.A.R. 0.35 GPD/FT²

Septic Tank: 1000 Gallons: STB 1007 Date 6-11-01

Pump Tank: Gallons; PT Date

Pump Make: Model Serial No.

Nitrification Field: No Fields 1 Square Feet 1035 Linear Feet 345

No Lines FOUR Trench Width 36" Max Trench Bottom Depth 36"

☑ New System ☐ Repair System Type: I II III IV V VI

System Description: CONVENTIONAL GRAVITY

Repair System Description: CONV. GRAVITY

Maintenance Agreement Required: ☐ Yes ☑ No

Gravel Depth 12" ☐ Slab ☐ Crawl Space ☑ Basement w/plumbing ☐ Basement wo/plumbing

☑ House/Mod. Home ☐ Mobile Home ☐ Business ☐ Other


No. Bedrooms 3 No. Bathrooms 3 No. Employees

Water Supply: ☑ Individual ☐ Public ☐ Community WELL


Comments/Conditions:

Comments/Conditions: ① SEPTIC TANK WITH RISERS INSTALLED USING "POLYLOK" FILTER ② SYSTEM INSTALLED DURING PERIOD OF WET WEATHER

INITIAL SITE SKETCH

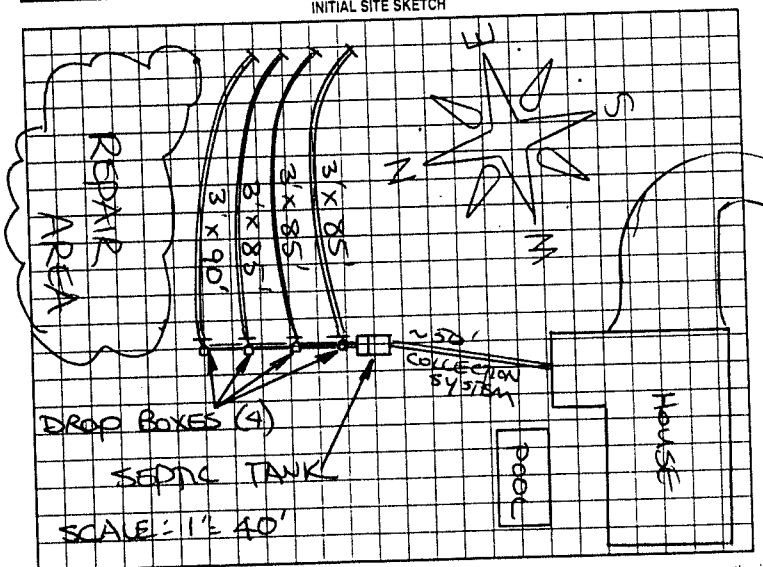

AS BUILT SKETCH

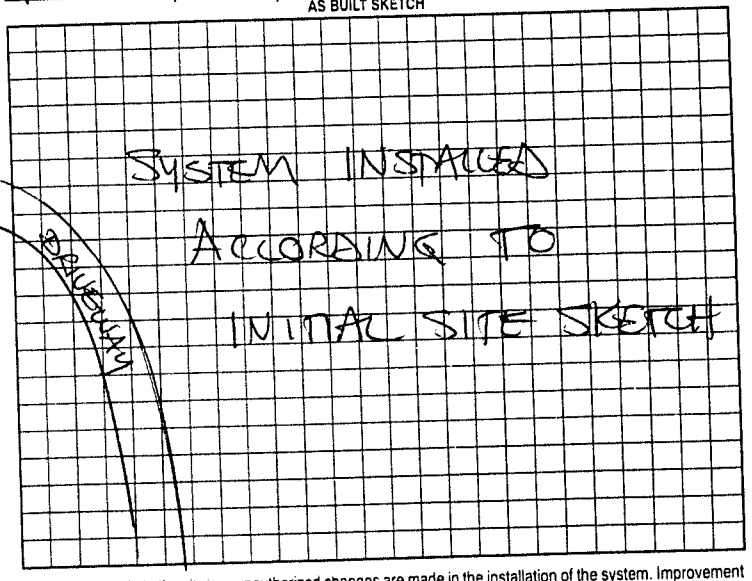

Permit can be suspended or revoked if any false information is supplied toward securing the permit/any unauthorized changes are made to the site/any unauthorized changes are made in the installation of the system. Improvement Permit with plat valid without expiration. Improvement Permit with site plan valid for sixty months. Authorization to Construct is valid for a period equal to that of Improvement Permit – not to exceed sixty months.

Signed: [signature] date 6-8-01

Improvement Permit by: STEVE HEDRICK date 6-8-01

Authorization to Construct by: STEVE HEDRICK date 6-8-01

Installed by: JAMES HUALER

Operation Permit by: STEVE HEDRICK date 8-30-01

Existing System Inspection by: date

HEALTH DEPT COPY WHITE OWNER COPY (FINAL) YELLOW OWNER COPY (INITIAL) PINK