IREDELL COUNTY HEALTH DEPARTMENT

Statesville Phone TR 3-7271 . Mooresville Phone No. 664-5281

PERMIT TO INSTALL SEPTIC TANK

Permit No. [illegible] Permit Date 8-10 1973

Owner R.T. Dishmon Address Union Grove Rt 1

Installed By Harlee Lackey Address Stony Point N.C.


Location of Property Hwy 115 - Past Lee Reid Mountain T.L on Rd #1595. Go abt 2 Miles Trailer on R. Off of Rd.

Tank		Capacity		Length of Lines		Fixtures	
Block	( )	1000	(✓)	225'	(✓)	No. of Baths	(1)
Precast	(✓)	1250	( )	250'	( )	Dishwasher	(—)
		1500	( )	Other		Garbage Grdr.	(—)
		Other				Other	

NOTIFY HEALTH DEPARTMENT AT LEAST EIGHT HOURS BEFORE TANK IS TO BE INSPECTED.

Final Inspection 8-10 1973 Approved (✓) Disapproved ( )

Remarks Water from Spring Near road

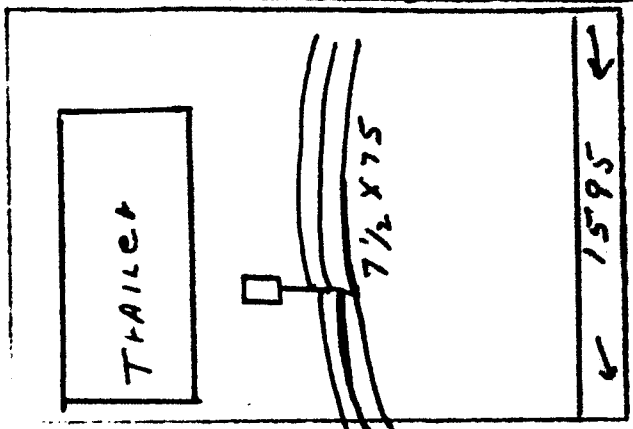

Sketch of Installation

E. A. Stevenson

Sanitarian