IREDELL COUNTY HEALTH DEPARTMENT

STATESVILLE 704-878-5305 MOORESVILLE 704-664-5281

IMPROVEMENT PERMIT / AUTHORIZATION TO CONSTRUCT / OPERATION PERMIT / EXISTING SYSTEM INSPECTION

PERMIT# 080822 PIN# 4813 06 5290 DATE 10-27-99

OWNER OR CONTRACTOR CHARLIE WILLIAMS PHONE: Business Home 592-2338

ADDRESS 139 BURKE FARM LOOP, UNION GROVE, NC 28689

LOCATION NC 115 North, TL LINNEYS MILL ROAD, LOT on LEFT ACROSS FROM OAK HOLLOW ROAD

SUBDIVISION BLOCK / SECTION LOT LOT AREA 38.14 ACRES SITE CLASS PS DESIGN FLOW 360 L.T.A.R. 0.30 GPD/FT²

Septic Tank: 1000 Gallons; STB 1012 Date 8-21-99
Pump Tank: Gallons; PT Date
Pump Make: Model Serial No.
Nitrification Field: No Fields 1 Square Feet 1200 Linear Feet 400
No Lines FOUR Trench Width 36" Max Trench Bottom Depth 36" Gravel Depth 12"

✓ New System Repair System Type: I II III IV V VI
System Description: CONVENTIONAL GRAVITY
Repair System Description: MAX. FEASIBLE
Maintenance Agreement Required: Yes ✓ No


House/Mod. Home No. Bedrooms 3
✓ Mobile Home No. Bathrooms 2
Business No. Employees
Other
Slab ✓ Crawl Space Basement w/plumbing Basement wo/plumbing

Water Supply: ✓ Individual ☐ Public ☐ Community SPRING

Comments/Conditions:

Comments/Conditions: SEPTIC TANK WITH RISERS INSTALLED USING "POLYLOK" FILTER

INITIAL SITE SKETCH

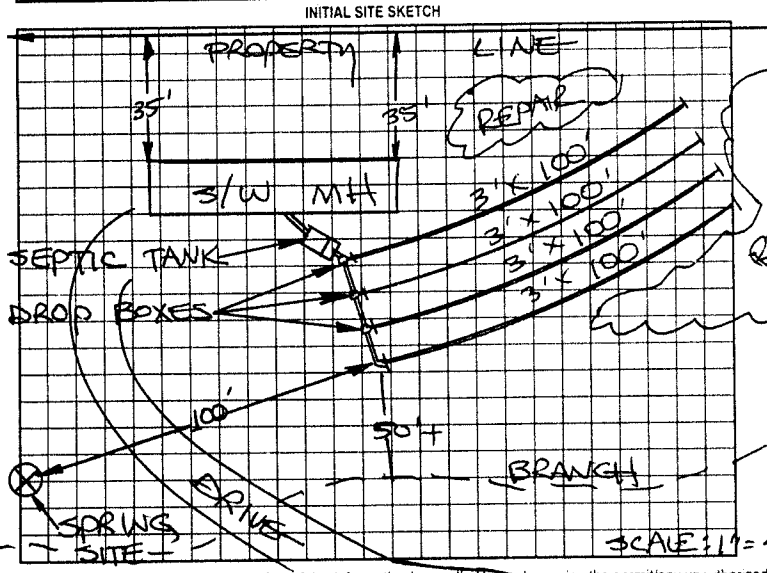

AS BUILT SKETCH

SYSTEM INSTALLED FOLLOWING PERIOD OF WET WEATHER. LOWEST LINE INSTALLED OUT OF CONTOUR AND CAN'T BE ADJUSTED. ADDITIONAL STONE INSTALLED IN UPPER LINE.

Permit can be suspended or revoked if any false information is supplied toward securing the permit/any unauthorized changes are made to the site/any unauthorized changes are made in the installation of the system. Improvement Permit with plat valid without expiration. Improvement Permit with site plan valid for sixty months. Authorization to Construct is valid for a period equal to that of Improvement Permit – not to exceed sixty months.

Signed: Charlie Williams date 10-27-99 Installed by: JEFF HURLBUT

Improvement Permit by: STEVE HEDRICK date 10-27-99 Operation Permit by: STEVE HEDRICK date 11-9-99

Authorization to Construct by: STEVE HEDRICK date 10-27-99 Existing System Inspection by: date

HEALTH DEPT COPY WHITE OWNER COPY (FINAL) YELLOW OWNER COPY (INITIAL) PINK

LINNEY'S MILL ROAD (SR 1598)