IREDELL COUNTY HEALTH DEPARTMENT

Statesville Office (704) 878-5305 Mooresville Office (704) 660-3625 PERMIT # 210910

IMPROVEMENT PERMIT / AUTHORIZATION TO CONSTRUCT / OPERATION PERMIT / EXISTING SYSTEM

PIN # 4813157599

APPLICANT: Cecil Marlowe APPLICANT ADDRESS: 604 Linney's Mill Rd Union Grove NC

SITE ADDRESS: 604 Linney's Mill Rd Union Grove NC 28689 PHONE: 704-592-2032 ALT. PHONE: 704-495-1368

SITE DIRECTIONS: I-77 N T/L Linneys Mill Rd 2.5 miles to (R) on Bowles Stable Rd 1st property on left

SUBDIVISION: N/A SECTION: N/A LOT # N/A LOT AREA: 0.963ac DESIGN FLOW: 240 L.T.A.R.: 0.3


Septic Tank	1000 (gal)	STB	854	Date	6-8-15	[X] New System	[ ] Repair	[ ] Expansion	System Type: I II [III] IV V VI
Pump Tank	N/A (gal)	PT	N/A	Date	N/A	System Description:	25% Reduction		
Pump Make	N/A	Model	16/11/04	Serial #	PL-6L	Repair System Description:	50% Reduction		
# Nitrification Fields	1	# Lines	3	Linear Ft:	200	Maintenance Agreement Required:	[ ] YES	[X] NO	
Trench Width	36"	Max. Trench Bottom Depth	36"	Gravel Depth	N/A		[X] GRAVITY	[ ] PRESSURE	

[X] Residence No. Bedrooms 2
[ ] Business No. Persons 4
[ ] Other No. Employees
[ ] Slab [X] Crawl Space
[ ] Basement w/plumbing [ ] Basement w/o plumbing


Water Supply: [X] Private [ ] Public [ ] Community

Comments / Conditions: Install 25% Reduction on Contour with Serial distribution

INITIAL SITE SKETCH

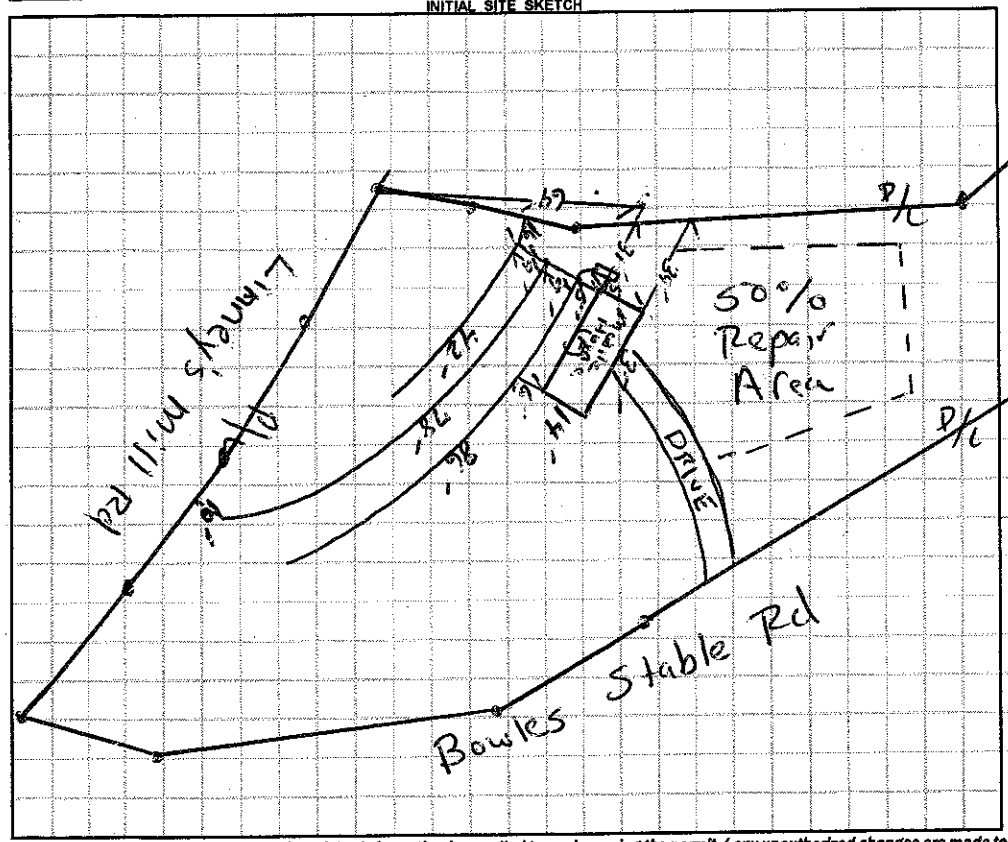

AS BUILT SKETCH 1"=60'

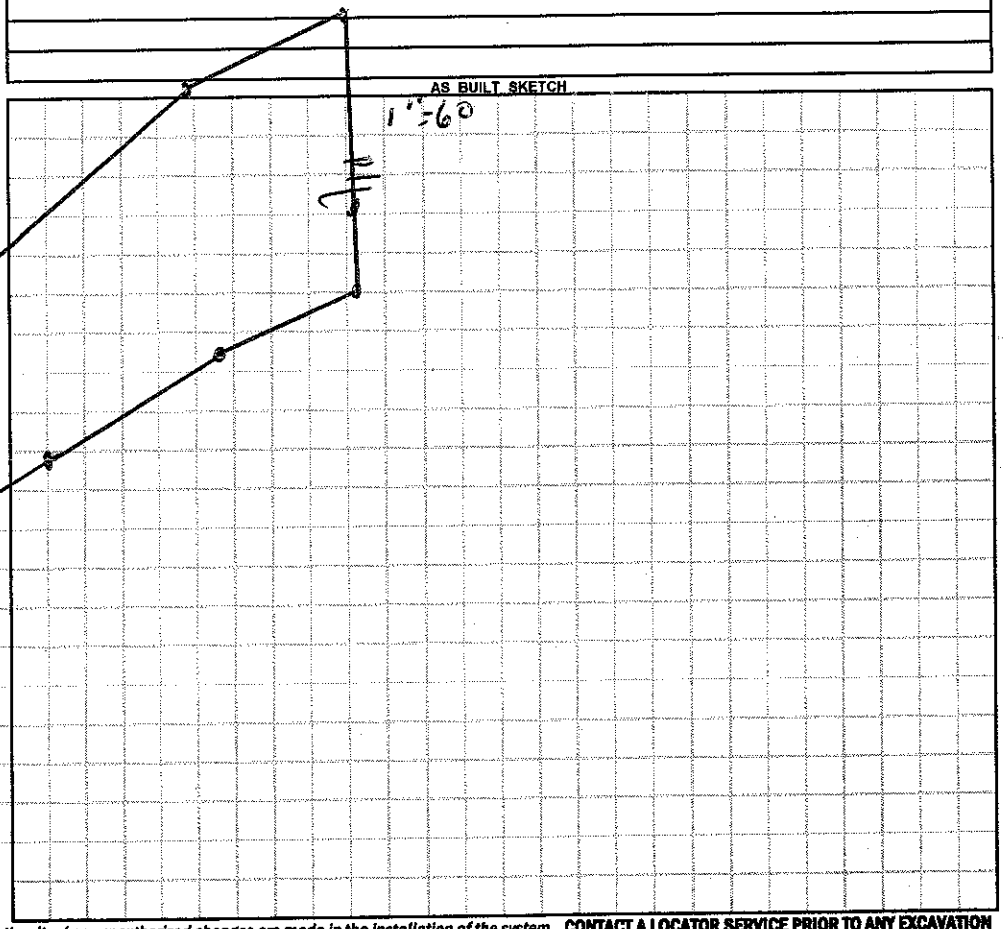

Permit can be suspended or revoked if any false information is supplied toward securing the permit / any unauthorized changes are made to the site / any unauthorized changes are made in the installation of the system. **CONTACT A LOCATOR SERVICE PRIOR TO ANY EXCAVATION**

[ ] **IMPROVEMENT PERMIT** *with plat valid without expiration.* [X] **IMPROVEMENT PERMIT** *with site plan valid for 60 mos.* [X] **AUTHORIZATION TO CONSTRUCT** *valid for period equal to IMPROVEMENT PERMIT--not to exceed 60 mo.*

Owner / Applicant Signature: Cecil Marlowe Date: 7-7-15 Installed by: Blackburn & Sons

IMPROVEMENT PERMIT by: Robert Hahn Date: 07/06/15 OPERATION PERMIT by: Robert Hahn Date: 12/22/15

AUTHORIZATION TO CONSTRUCT by: Robert Hahn Date: 07/06/15 Existing System Inspected by: Date:

Health Dept. Copy - WHITE Applicant (Final Approval) - YELLOW Applicant (Conditional Approval) - PINK