IREDELL COUNTY HEALTH DEPARTMENT

Statesville Phone TR 3-7271 Mooresville Phone No. 664-5281

PERMIT TO INSTALL SEPTIC TANK

Permit No. _____ Permit Date 8-2 1973

Owner Friendship Baptist Church Address Union Grove Rt. 1.

Installed By James Hartness Address Union Grove Rt 1.


Location of Property 115 N. Tk. 2nd Rd Past Gale Redmons Store (Bushy Mountain Rd #1598) T.R. on Rd #1606 - Church on L.

Tank		Capacity		Length of Lines		Fixtures	
Block	( )	1000	( )	225'	( )	No. of Baths	(2)
Precast	(✓)	1250	( )	250'	(✓)	Dishwasher	( )
		1500	(✓)	Other _____		Garbage Grdr.	( )
		Other _____				Other _____	

NOTIFY HEALTH DEPARTMENT AT LEAST EIGHT HOURS BEFORE TANK IS TO BE INSPECTED.

Final Inspection 8-2 1973 Approved (✓) Disapproved ( )

Remarks Well 50' from Tank.

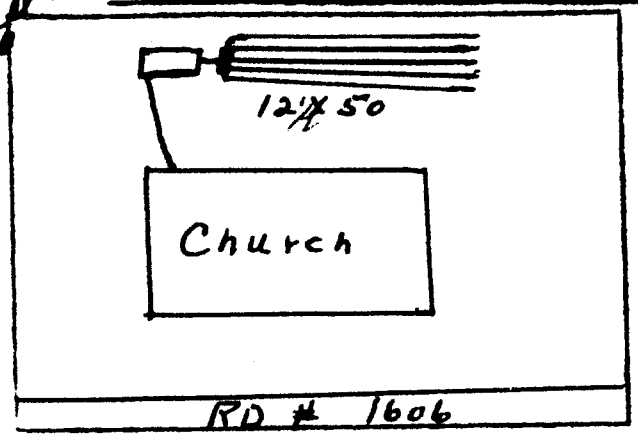

Sketch of Installation

Permission to put more than 3 lines wide given by Mr Cuss Hall.

E. A. Stevenson

Sanitarian