IREDELL COUNTY HEALTH DEPARTMENT

STATESVILLE 704-878-5305 MOORESVILLE 704-664-5281

IMPROVEMENT PERMIT / AUTHORIZATION TO CONSTRUCT / OPERATION PERMIT / EXISTING SYSTEM INSPECTION

PERMIT# 103250 PIN# 4813-35-7613 DATE 11-09-01

OWNER OR CONTRACTOR SYBLE BROWN PHONE: Business Home (704) 592-2396

ADDRESS 170 LAMARR ROAD, UNION GROVE NC 28689

LOCATION NC 115 N, TL LINNEY'S MILL RD, TR LAMARR RD, 1ST MH ON RIGHT

SUBDIVISION BLOCK / SECTION LOT LOT AREA 0.93 ACRE SITE CLASS PS DESIGN FLOW 360 L.T.A.R. EXISTING

Septic Tank: 1000 Gallons: STB Date

Pump Tank: Gallons: PT Date

Pump Make: Model Serial No.

Nitrification Field: No. Fields 1 Square Feet 900 Linear Feet 300

No. Lines THREE Trench Width 36" Max Trench Bottom Depth 36 Gravel Depth 12"

☒ New System ☐ Repair System Type: I. II. IV. V. VI

System Description: CONVENTIONAL GRAVITY

Repair System Description:

Maintenance Agreement Required: ☐ Yes ☒ No

☐ Slab ☒ Crawl Space ☐ Basement w/plumbing ☐ Basement wo/plumbing

☐ House/Mod. Home No. Bedrooms 3

☒ Mobile Home No. Bathrooms 2

☐ Business No. Employees


☐ Other

Water Supply: ☒ Individual ☐ Public ☐ Community WELL


Comments/Conditions:

Comments/Conditions: SYSTEM CROSSES PROPERTY LINE AS SHOWN (15A NCAC 18A .1962)

INITIAL SITE SKETCH

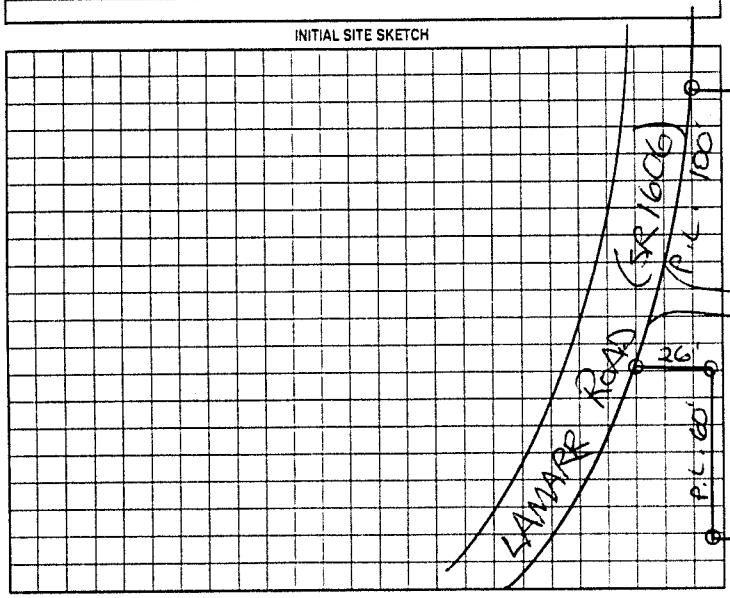

AS BUILT SKETCH ~ SCALE: 1"=50'

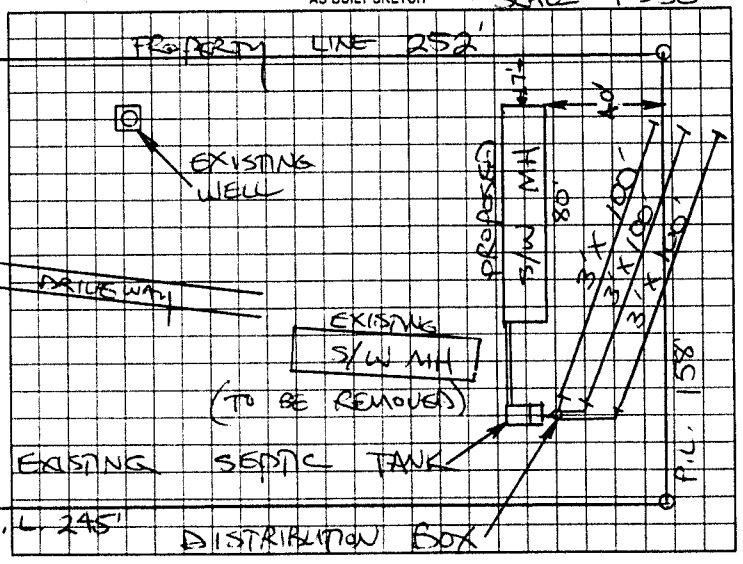

Permit can be suspended or revoked if any false information is supplied toward securing the permit; any unauthorized changes are made to the site; any unauthorized changes are made in the installation of the system. Improvement Permit with plat valid without expiration. Improvement Permit with site plan valid for sixty months. Authorization to Construct is valid for a period equal to that of Improvement Permit – not to exceed sixty months.

Signed: date

Improvement Permit by: date

Authorization to Construct by: date

Installed by:

Operation Permit by: date

Existing System Inspection by: STEVE HERRICK date 11-09-01

HEALTH DEPT. COPY: WHITE OWNER COPY (FINAL): YELLOW OWNER COPY (INITIAL): PINK