IREDELL COUNTY HEALTH DEPARTMENT

Statesville Phone TR 3-7271 Mooresville Phone NO 3-1271

PERMIT TO INSTALL SEPTIC TANK

Permit NO. _____ Permit Date 11-22 1965

Owner F. D. Wilbanks Address R/1 Union, NC

Installed By C. E. Talbert Address Union Grove,


Location of Property Hwy 115 & Taylor Spring Church Rd see. Turn on left before Church

Tank		Capacity		Length of Lines		Fixtures	
Block	( )	1000	(✓)	225'	(✓)	No. of Baths	( )
Precast	( )	1250	( )	250'	( )	Dishwasher	( )
		1500	( )	Other _____		Garbage Grdr.	( )
		Other _____				Other _____	

NOTIFY HEALTH DEPARTMENT AT LEAST EIGHT HOURS BEFORE TANK IS TO BE INSPECTED.

Final Inspection 11-22 1965 Approved (✓) Disapproved ( )

Remarks No well within 50 feet of Septic Tk Installation

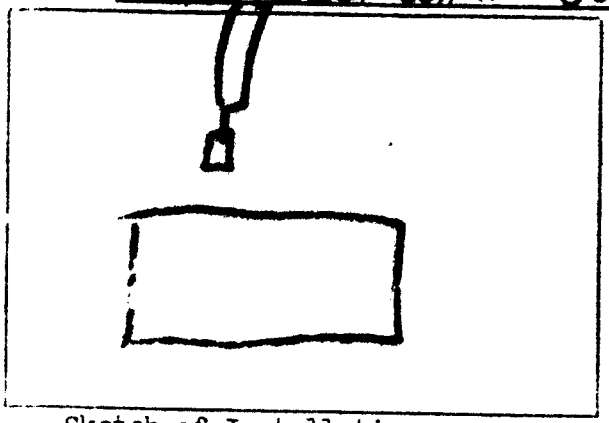

Sketch of Installation

Andrew O. Hutchinson R.S.

Sanitarian