IREDELL COUNTY HEALTH DEPARTMENT

Statesville Phone TR 3-7271 Mooresville Phone NO 3-1271

PERMIT TO INSTALL SEPTIC TANK

Permit NO. 72 Permit Date DEC. 5 1970

Owner TAYLOR SPRINGS Baptist Church Address Rt. 1 - Union Grove, NC

Installed By TOM WILLIAMS + Co. Address Rt. 1 Union Grove, NC 7596


Location of Property 115 NORTH - TURN LEFT ON ROAD [redacted] ON LEFT PAST NEW HOPE Community BLDG.

Tank		Capacity		Length of Lines		Fixtures	
Block	( )	1000	( )	225'	( )	No. of Baths	(2)
Precast	(✓)	1250	(✓)	250'	( )	Dishwasher	( )
		1500	( )	Other 310		Garbage Grdr.	( )
		Other				Other	

NOTIFY HEALTH DEPARTMENT AT LEAST EIGHT HOURS BEFORE TANK IS TO BE INSPECTED.

Final Inspection DEC. 8 1970 Approved (✓) Disapproved ( )

Remarks

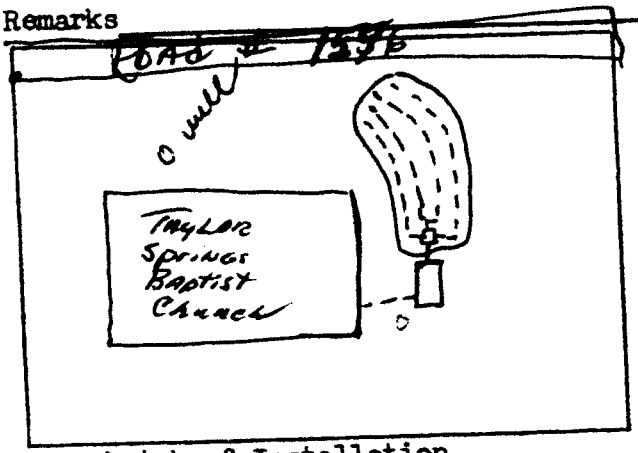

Sketch of Installation

Sanitarian