IREDELL COUNTY HEALTH DEPARTMENT

STATESVILLE 704-878-5305 MOORESVILLE 704-664-5281

IMPROVEMENT PERMIT / AUTHORIZATION TO CONSTRUCT / OPERATION PERMIT / EXISTING SYSTEM INSPECTION

PERMIT# 084263 PIN# 4813 67 5810 (PART) DATE 11-10-99

OWNER OR CONTRACTOR MILDRED F. HURLBUT PHONE: Business Home 592-4901

ADDRESS 362 SANDBURG ROAD, UNION GROVE, NC 28689

LOCATION NC 115 NORTH, TL SANDBURG ROAD, .10 MILE ON RIGHT, BACK OFF ROAD ~500 FEET

SUBDIVISION BLOCK / SECTION LOT LOT AREA 10.83 ACRES SITE CLASS PS DESIGN FLOW 360 L.T.A.R. 0.25 GPD/FT²

Septic Tank: 1000 Gallons; STB 1012 Date 12-9-99
Pump Tank: Gallons; PT Date
Pump Make: Model Serial No.
Nitrification Field: No Fields 1 Square Feet 1440 Linear Feet 480
No Lines FOUR Trench Width 36" Max Trench Bottom Depth 30" Gravel Depth 12"

☑ New System ☐ Repair System Type: I. II. III. IV. V. VI
System Description: CONVENTIONAL GRAVITY
Repair System Description: LOW PRESSURE PIPE
Maintenance Agreement Required: ☐ Yes ☑ No


☐ House/Mod. Home ☑ Mobile Home ☐ Business ☐ Other
No. Bedrooms 3 No. Bathrooms 2 No. Employees
☐ Slab ☑ Crawl Space ☐ Basement w/plumbing ☐ Basement wo/plumbing

Water Supply: ☑ Individual ☐ Public ☐ Community
SPRING


Comments:/Conditions: INSTALL SUBSURFACE INTERCEPT DRAINAGE DITCH AT LOCATION SHOWN BEGINNING 42" DEEP OUT TO DAYLIGHT

Comments:/Conditions:

INITIAL SITE SKETCH

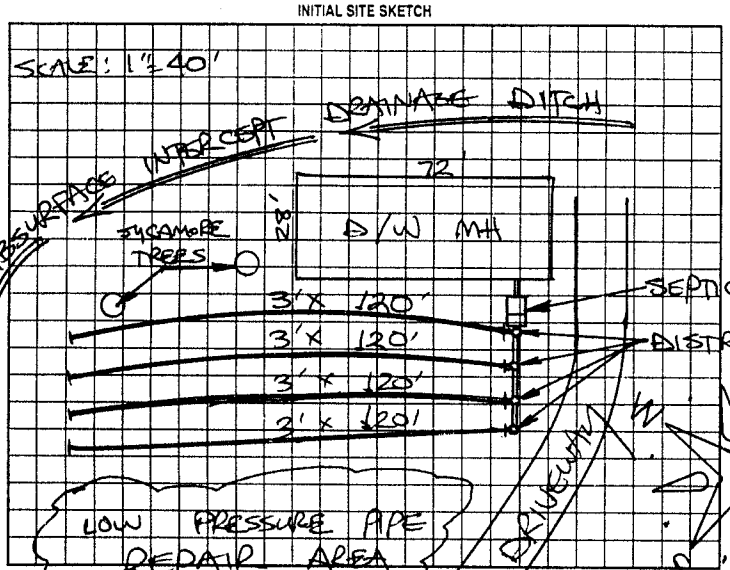

AS BUILT SKETCH

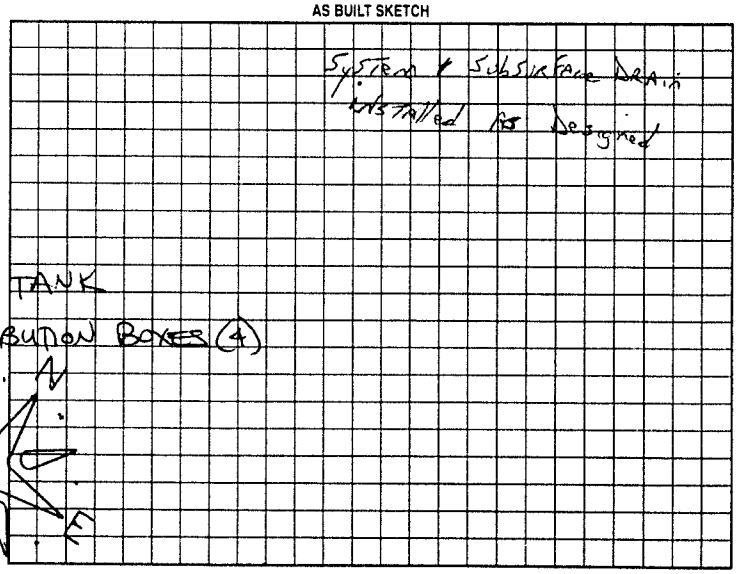

Permit can be suspended or revoked if any false information is supplied toward securing the permit/any unauthorized changes are made to the site/any unauthorized changes are made in the installation of the system. Improvement Permit with plat valid without expiration. Improvement Permit with site plan valid for sixty months. Authorization to Construct is valid for a period equal to that of Improvement Permit – not to exceed sixty months.

Signed: [signature] date 11-10-99 Installed by: Union Grove Septic

Improvement Permit by: STEVE HEDRICK date 11-10-99 Operation Permit by: [signature] date June 7, 2000

Authorization to Construct by: STEVE HEDRICK date 11-10-99 Existing System Inspection by: date

HEALTH DEPT. COPY: WHITE OWNER COPY (FINAL): YELLOW OWNER COPY (INITIAL): PINK