IREDELL COUNTY HEALTH DEPARTMENT

Statesville Phone TR 3-7271 — Mooresville Phone NO 3-1271

PERMIT TO INSTALL SEPTIC TANK

Permit No. 273 — Permit Date Aug 18 1970

Owner New Hope Community Bldg. — Address Rt. 1 Union Grove, NC.

Installed By Tom Williams + Comp. Staff — Address " "


Location of Property NORTH ON HIGHWAY 115 - TURN LEFT ON ROAD # 1596 - NEAR Taylor Springs Bapt. Church

Tank		Capacity		Length of Lines		Fixtures	
Block	( )	1000	( )	225'	( )	No. of Baths	(2)
Precast	(✓)	1250	(✓)	250'	( )	Dishwasher	( )
		1500	( )	Other 300		Garbage Grdr.	( )
		Other				Other	

NOTIFY HEALTH DEPARTMENT AT LEAST EIGHT HOURS BEFORE TANK IS TO BE INSPECTED.

Final Inspection Aug. 18 - 70 19__ — Approved (✓) Disapproved ( )

Remarks Plastic Pipe in Nitrification Field

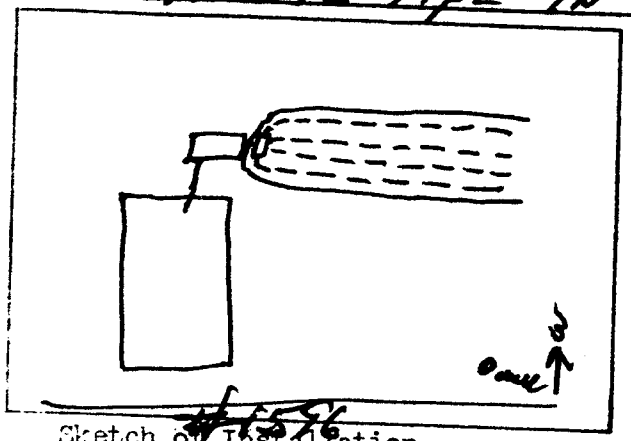

Sketch of Installation

Sanitarian