IREDELL COUNTY HEALTH DEPARTMENT

Statesville Phone TR 3-7271 Mooresville Phone NO 3-1271

PERMIT TO INSTALL SEPTIC TANK

Permit No. 259 Permit Date AUG - 3 1970

Owner FRANK LOTT Address Rt. 1 Union Grove, NC

Installed By James Hartness Address Rt. 1 Union Grove, NC

Location of Property

Across Road From New Hope Community Bldg.


Road # 1596

Tank		Capacity		Length of Lines		Fixtures	
Block	( )	1000	(✓)	225'	( )	No. of Baths	(2)
Precast	(✓)	1250	( )	250'	( )	Dishwasher	(✓)
		1500	( )	Other 30c		Garbage Grdr.	(✓)
		Other				Other	

NOTIFY HEALTH DEPARTMENT AT LEAST EIGHT HOURS BEFORE TANK IS TO BE INSPECTED.

Final Inspection Aug. 3 1970 Approved (✓) Disapproved ( )

Remarks No Well on Property. (At time septic Tank was installed)

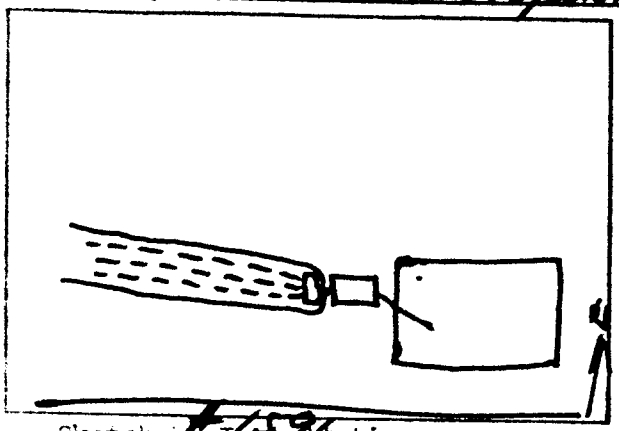

Sketch of Installation

Sanitarian