IREDELL COUNTY HEALTH DEPARTMENT - *ENVIRONMENTAL HEALTH* ☑ STATESVILLE OFFICE 704-878-5305 ☐ MOORESVILLE OFFICE 704-664-5281

IMPROVEMENT PERMIT / AUTHORIZATION TO CONSTRUCT / OPERATION PERMIT / EXISTING SYSTEM INSPECTION

PERMIT # RepairR PIN # 4813-91-6841 DATE 3 November 2011

OWNER Phillip Redmond APPLICANT: Jared Lentz PHONE: Home/Cell # (704) 902-4602 Business #

SITE ADDRESS 216 Race Path Rd. Mooresville OWNER / APPLICANT ADDRESS

SITE DIRECTIONS I-77 N TL Race Path Rd. - Cross Bridge - Top of Hill on Rt.

SUBDIVISION BLOCK / SECTION LOT # LOT AREA 1.30c. DESIGN FLOW 360 gpd L.T.A.R. 0.3 g/ft²/d

Septic Tank 1000 Gallons: STB 760 Date 10-12 ☐ New System ☑ Repair ☐ Expansion System Type I II (III) IV V VI

Pump Tank Gallons: P T Date System Description:

Pump Make Model Serial # Repair System Description: 25% Reduction System.

No. Nitrification Fields: 1 No. Lines 3 Linear Feet 300 Maintenance Agreement Required ☐ YES ☑ NO

Trench Width 36" Max. Trench Bottom Depth 36" Gravel Depth NA ☑ GRAVITY ☐ PRESSURE


☑ Residence No. Bedrooms 3 ☐ Business No. Persons ☐ Other No. Employees ☐ Slab ☑ Crawl Space ☐ Basement w/plumbing ☐ Basement w/o plumbing

Water Supply: ☑ Private ☐ Public ☐ Community

Comments / Conditions

Polylock Fittings.

INITIAL SITE SKETCH

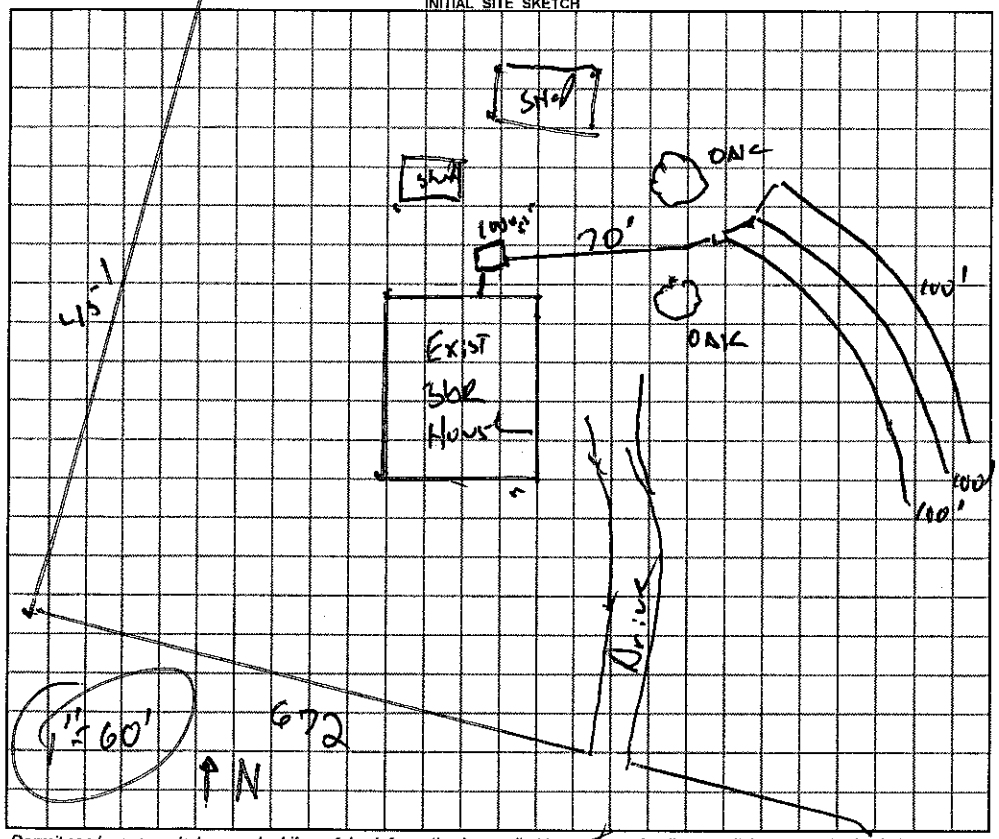

AS BUILT SKETCH

Installed As Drawn

Permit can be suspended or revoked if any false information is supplied toward securing the permit / any unauthorized changes are made to the site / any unauthorized changes are made in the installation of the system.

☐ ***IMPROVEMENT PERMIT*** with plat valid without expiration. ☑ ***IMPROVEMENT PERMIT*** with plat valid without expiration. site plan valid 60 mo. ☑ ***AUTHORIZATION TO CONSTRUCT*** valid for period equal to IMPROVEMENT PERMIT--not to exceed 60 mo.

Owner / Applicant Signature: Date 11-17-11 Installed by: JARED Lentz

IMPROVEMENT PERMIT by: REHS Date 3 Nov. 11 OPERATION PERMIT by: REHS Date 12-2-11

AUTHORIZATION TO CONSTRUCT by: REHS Date 3 Nov. 11 Existing System Inspected by: REHS Date

YOU SHOULD CONTACT A LOCATOR SERVICE PRIOR TO ANY EXCAVATION

White Copy -- Environmental Health YELLOW COPY (Final) Owner / Applicant PINK COPY (Initial) Owner / Applicant