IREDELL COUNTY HEALTH DEPARTMENT

STATESVILLE 704-878-5305 (<1) MOORESVILLE 704-664-5281

IMPROVEMENT PERMIT / AUTHORIZATION TO CONSTRUCT / OPERATION PERMIT / EXISTING SYSTEM INSPECTION

PERMIT# 102335 PIN# 4813-92-0968

OWNER OR CONTRACTOR PHILLIP REDMOND PHONE: Business (704) 878-3180 Home (704) 592-5862 DATE 9-25-01

ADDRESS 216 RACE PATH ROAD, STATESVILLE, NC 28625

LOCATION NC 115 N, TL LINNEY'S MILL RD, 0.4 MILE ON LEFT

SUBDIVISION _____ BLOCK / SECTION _____ LOT _____ LOT AREA 29.7 ACRES SITE CLASS. I-S DESIGN FLOW 480 L.T.A.R. 0.30 GPD/FT²

Septic Tank: ~~1000~~ 1500 Gallons: STB 1011 Date 7-2-02

Pump Tank: 1500 Gallons: PT _____ Date _____

Pump Make: _____ Model _____ Serial No. _____

Nitrification Field: No. Fields 1 Square Feet 1600 Linear Feet 533

No Lines FOUR Trench Width 36" Max Trench Bottom Depth 30" Gravel Depth 12"

☑ New System ☐ Repair System Type: I II III IV V VI

System Description: CONVENTIONAL GRAVITY

Repair System Description: CONV. GRAVITY

Maintenance Agreement Required: ☐ Yes ☑ No

☑ House/Mod. Home No. Bedrooms 4

☐ Mobile Home No. Bathrooms 3.5

☐ Business No. Employees ____

☐ Other _____


☐ Slab ☐ Crawl Space ☑ Basement w/plumbing ☐ Basement wo/plumbing

Water Supply: ☑ Individual ☐ Public ☐ Community WELL

Comments/Conditions: KEEP SYSTEM MINIMUM 100 FEET FROM WELL

Comments/Conditions 1500 GALLON SEPTIC TANK WITH RISERS & MARKER INSTALLED USING "POLY LOK" FILTER

SCALE: 1" = 40' INITIAL SITE SKETCH

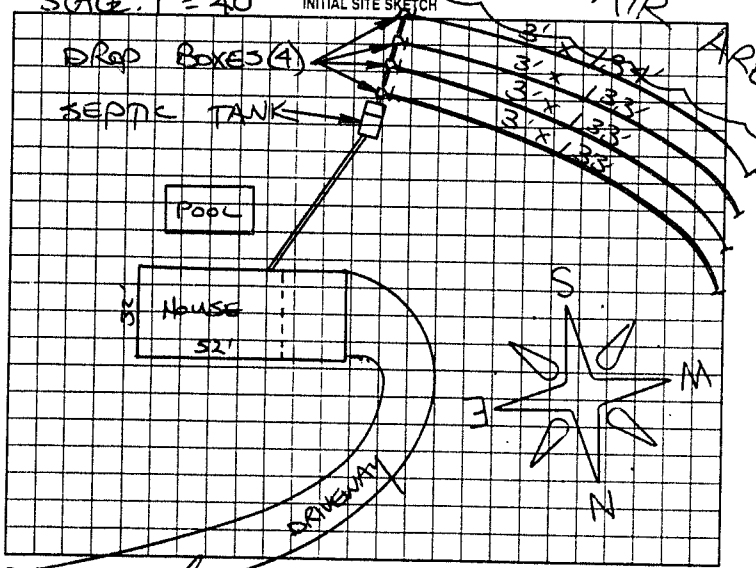

AS BUILT SKETCH

SYSTEM INSTALLED ACCORDING TO INITAL SITE SKETCH

Permit can be suspended or revoked if any false information is supplied toward securing the permit/any unauthorized changes are made to the site/any unauthorized changes are made in the installation of the system. Improvement Permit with plat valid without expiration. Improvement Permit with site plan valid for sixty months. Authorization to Construct is valid for a period equal to that of Improvement Permit – not to exceed sixty months.

Signed: Phillip H Redmond date 9-25-01

Improvement Permit by: STEVE HEDRICK date 9-25-01

Authorization to Construct by: STEVE HEDRICK date 9-25-01

LINNEY'S MILL ROAD HEALTH DEPT COPY (WHITE) OWNER COPY (FINAL) YELLOW OWNER COPY (INITIAL) PINK

Installed by: DAVID YOUNTZ

Operation Permit by: STEVE HEDRICK date 8-15-02

Existing System Inspection by: _____ date _____