IREDELL COUNTY HEALTH DEPARTMENT

Statesville Office (704) 878-5305 Mooresville Office (704) 660-3625 PERMIT # 209922

IMPROVEMENT PERMIT / AUTHORIZATION TO CONSTRUCT / OPERATION PERMIT / EXISTING SYSTEM

PIN # 4814437207

APPLICANT: Old Southern Development APPLICANT ADDRESS: PO Box 248 Troutman

SITE ADDRESS: 299 Paddock Rd. PHONE: 704-902-2057 ALT. PHONE: N/A


SITE DIRECTIONS: Hwy 115N TL Paddock Rd. Property on Left.

SUBDIVISION: N/A SECTION: N/A LOT # N/A LOT AREA: 31.86 acres DESIGN FLOW: 360gpd L.T.A.R.: 0.25


Septic Tank	1000	(gal)	STB	1017	Date	3-19-15	☑ New System	☐ Repair	☐ Expansion	System Type: I II ☑ III IV V VI	☑ Residence	No. Bedrooms	3	Water Supply	
Pump Tank	w/p	(gal)	PT	w/p	Date	w/p	System Description:	25% Reduction			☐ Business	No. Persons	6	☑ Private	
Pump Make	w/p	Model	Tuffstuff		Serial #	EF-4	Repair System Description:	25% Reduction			☐ Other	No. Employees		☐ Public	
# Nitrification Fields	1	# Lines	4		Linear Ft:	360	Maintenance Agreement Required:	☐ YES	☑ NO		☐ Slab	☑ Crawl Space		☐ Community	
Trench Width	36"	Max. Trench Bottom Depth	36"		Gravel Depth	N/A		☑ GRAVITY	☐ PRESSURE		☐ Basement w/plumbing		☐ Basement w/o plumbing		

Comments / Conditions: Install a 25% Reduction system on contour with serial distribution. Install Trench Bottoms @ 36" ~~A~~ A

INITIAL SITE SKETCH

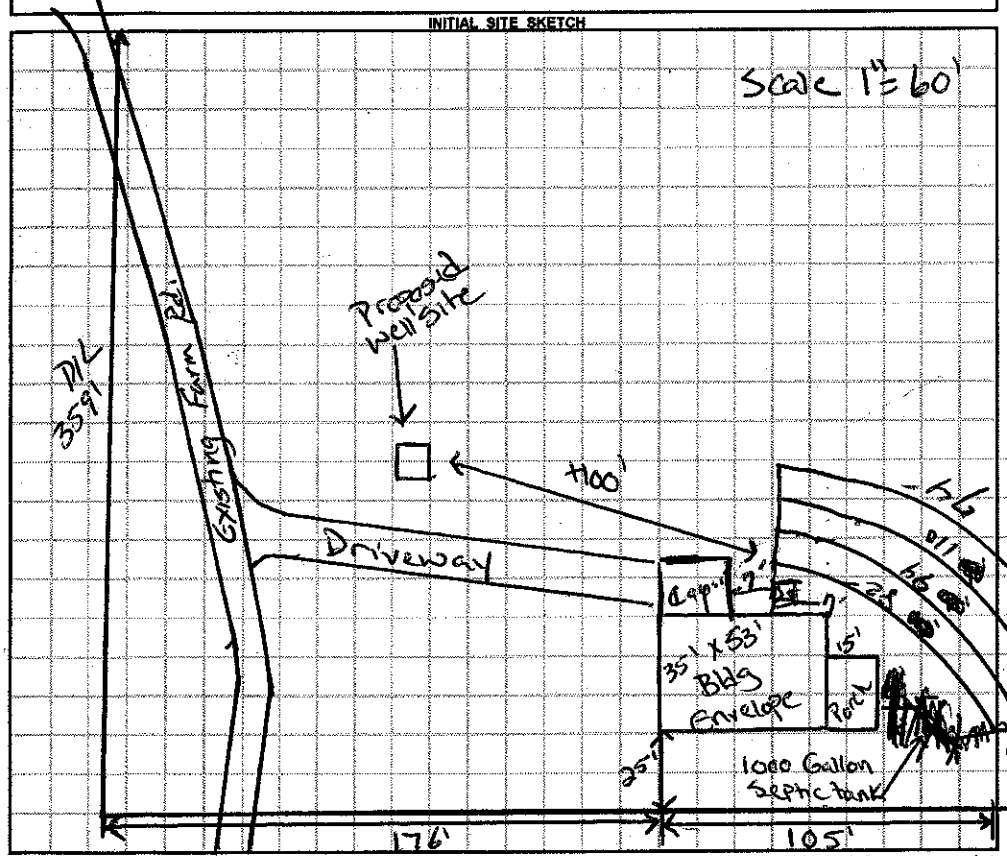

AS BUILT SKETCH

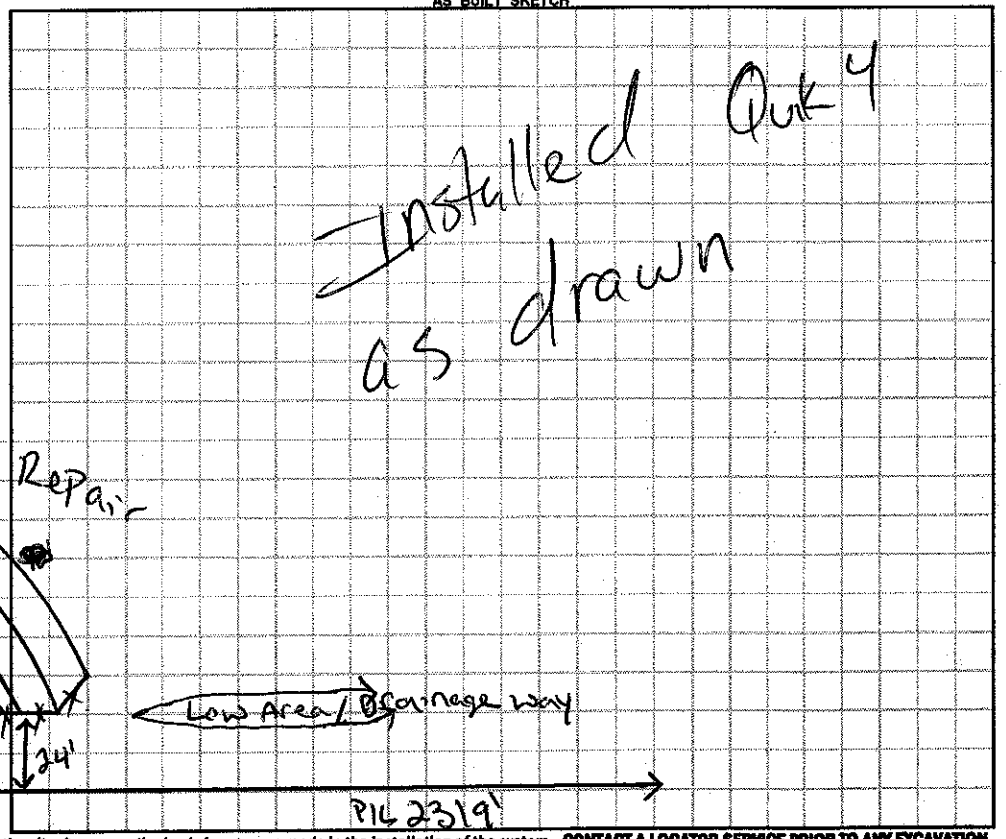

Permit can be suspended or revoked if any false information is supplied toward securing the permit / any unauthorized changes are made to the site / any unauthorized changes are made in the installation of the system. **CONTACT A LOCATOR SERVICE PRIOR TO ANY EXCAVATION**

☐ **IMPROVEMENT PERMIT** *with plat valid without expiration.* ☑ **IMPROVEMENT PERMIT** *with site plan valid for 60 mos.* ☑ **AUTHORIZATION TO CONSTRUCT** *valid for period equal to IMPROVEMENT PERMIT--not to exceed 60 mo.*

Owner / Applicant Signature: Ronnie Broom Date: 6-3-15 Installed by: Tommy Fryar

IMPROVEMENT PERMIT by: Justin Henderson Date: 6-2-15 OPERATION PERMIT by: Tommy Fryar Date: 10/20/15

AUTHORIZATION TO CONSTRUCT by: Justin Henderson Date: 6-2-15 Existing System Inspected by: Date:

Health Dept. Copy - WHITE Applicant (Final Approval) - YELLOW Applicant (Conditional Approval) - PINK