# IREDELL COUNTY HEALTH DEPARTMENT

STATESVILLE 704-878-5305 (C1) MOORESVILLE 704-664-5281

## IMPROVEMENT PERMIT / AUTHORIZATION TO CONSTRUCT / OPERATION PERMIT / EXISTING SYSTEM INSPECTION

PERMIT# 09546 9 PIN# 4814 62 7868 DATE 4-19-01

OWNER OR CONTRACTOR KELLY Welborn PHONE: Business Home 704-592-5331

ADDRESS 181 PADDOCK RD, Union Grove 28689

LOCATION 115 N, © PADDOCK, ① on 3-B Driveway

SUBDIVISION BLOCK / SECTION LOT LOT AREA 2.19+AC SITE CLASS AS DESIGN FLOW 360 L.T.A.R. 13

Septic Tank: 1000 Gallons; STB 1000 Date 7-30-02
Pump Tank: Gallons; PT Date
Pump Make: Model Serial No.
Nitrification Field: No Fields 1 Square Feet 1200 Linear Feet 400'
No Lines 2 Trench Width 36" Max Trench Bottom Depth 36" Gravel Depth 12"

X New System ☐ Repair System Type: I (II) III. IV. V. VI
System Description: CONV GRAV
Repair System Description: GRAV 25%. REP
Maintenance Agreement Required: ☐ Yes X No


X House/Mod. Home ☐ Mobile Home ☐ Business ☐ Other
No. Bedrooms 3 No. Bathrooms 3 No. Employees
☐ Slab ☐ Crawl Space X Basement w/plumbing ☐ Basement wo/plumbing

Water Supply: X Individual ☐ Public ☐ Community WELL


Comments/Conditions: ① FRENCH DRAIN MIN. 48" DEEP & BRING TO DAYLIGHT ② INSTALL LINE ON CONTOUR ③ STAY 10' OFF PROPERTY LINES 45' off house.

Comments/Conditions: SEPTIC TANK WITH MARKER INSTALLED USING "PolyLok" FILTER

INITIAL SITE SKETCH NOT TO SCALE

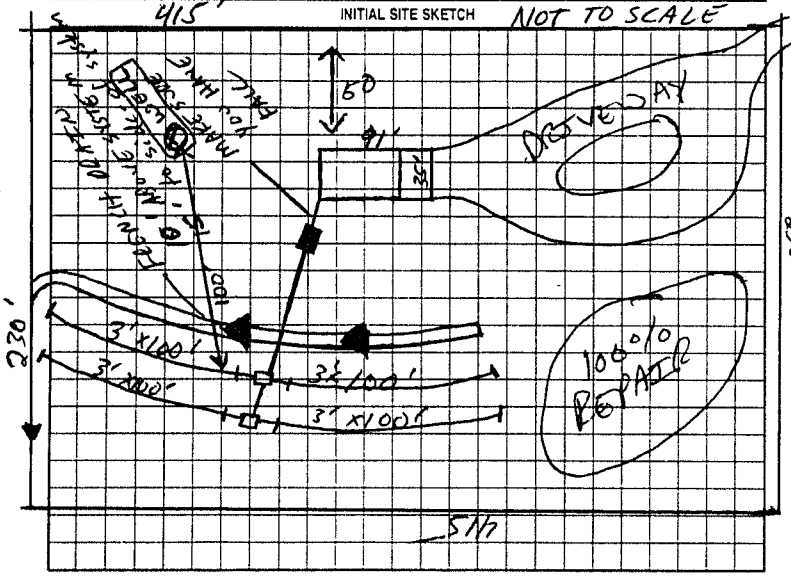


AS BUILT SKETCH

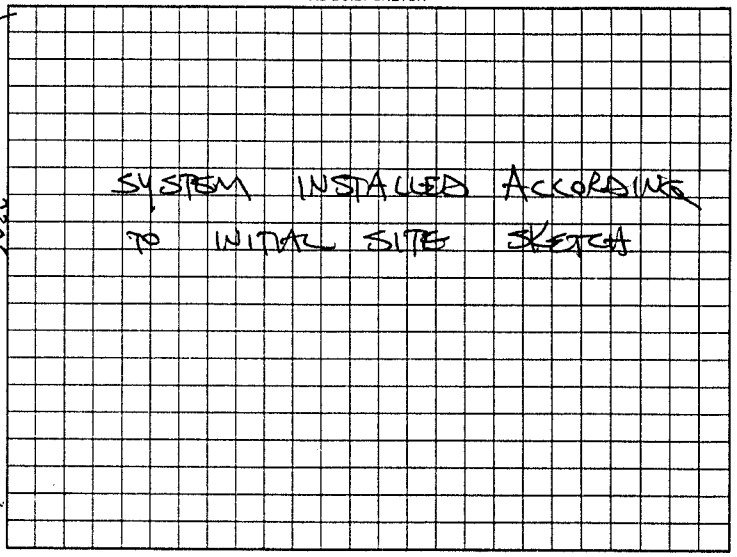


Permit can be suspended or revoked if any false information is supplied toward securing the permit/any unauthorized changes are made to the site/any unauthorized changes are made in the installation of the system. Improvement Permit with plat valid without expiration. Improvement Permit with site plan valid for sixty months. Authorization to Construct is valid for a period equal to that of Improvement Permit – not to exceed sixty months.

Signed: date

Improvement Permit by: date 4-19-01

Authorization to Construct by: date 4-19-01

Installed by: KELLY WELBORN

Operation Permit by: STEVE HENDRICK date 10-7-02

Existing System Inspection by: date

HEALTH DEPT. COPY: WHITE OWNER COPY (FINAL): YELLOW OWNER COPY (INITIAL): PINK