# IREDELL COUNTY HEALTH DEPARTMENT

STATESVILLE 704-878-5305 MOORESVILLE 704-664-5281

## IMPROVEMENT PERMIT / AUTHORIZATION TO CONSTRUCT / OPERATION PERMIT / EXISTING SYSTEM INSPECTION

PERMIT# 111426 PIN# 4814-65-7035 DATE 5-13-03

OWNER OR CONTRACTOR BRUCE & MARY HOPE MILLIGAN PHONE: Business Home (704) 592-4400

ADDRESS 192 PADDOCK ROAD, UNION GROVE, NC 28689

LOCATION NC 115 NORTH TO PADDOCK ROAD 0.4 MILE ON RIGHT AT BOX # 192

SUBDIVISION BLOCK / SECTION LOT LOT AREA 2.0 ACRES SITE CLASS. PS DESIGN FLOW 600 L.T.A.R. 0.40 GPD/FT²

Septic Tank: 1500 Gallons; STB 10 11 Date 1-26-03
Pump Tank: Gallons; PT Date
Pump Make: Model Serial No.
Nitrification Field: No Fields 1 Square Feet 600 Linear Feet 200
No Lines TWO Trench Width 36" Max Trench Bottom Depth 36" Gravel Depth 12"

☑ New System ☐ Repair System Type: I (II) III, IV, V, VI
System Description: CONVENTIONAL GRAVITY
Repair System Description: CONV. GRAVITY
Maintenance Agreement Required: ☐ Yes ☑ No (PUMP)

☑ House/Mod. Home No. Bedrooms 4
☐ Mobile Home No. Bathrooms 2½
☐ Business No. Employees
☑ Other + OFFICE SPACE


☐ Slab ☐ Crawl Space ☐ Basement w/plumbing ☐ Basement wo/plumbing

Water Supply: ☑ Individual ☐ Public ☐ Community WELL


Comments/Conditions: CRUSH & FILL EXISTING SEPTIC TANK. INSTALL NEW 1500 GAL. SEPTIC TANK AT LOCATION SHOWN. EXPAND SYSTEM BY ADDING TWO 3' x 100' LINES AS SHOWN

Comments/Conditions: Tuff-Tite Filter & ST marker Installed

INITIAL SITE SKETCH

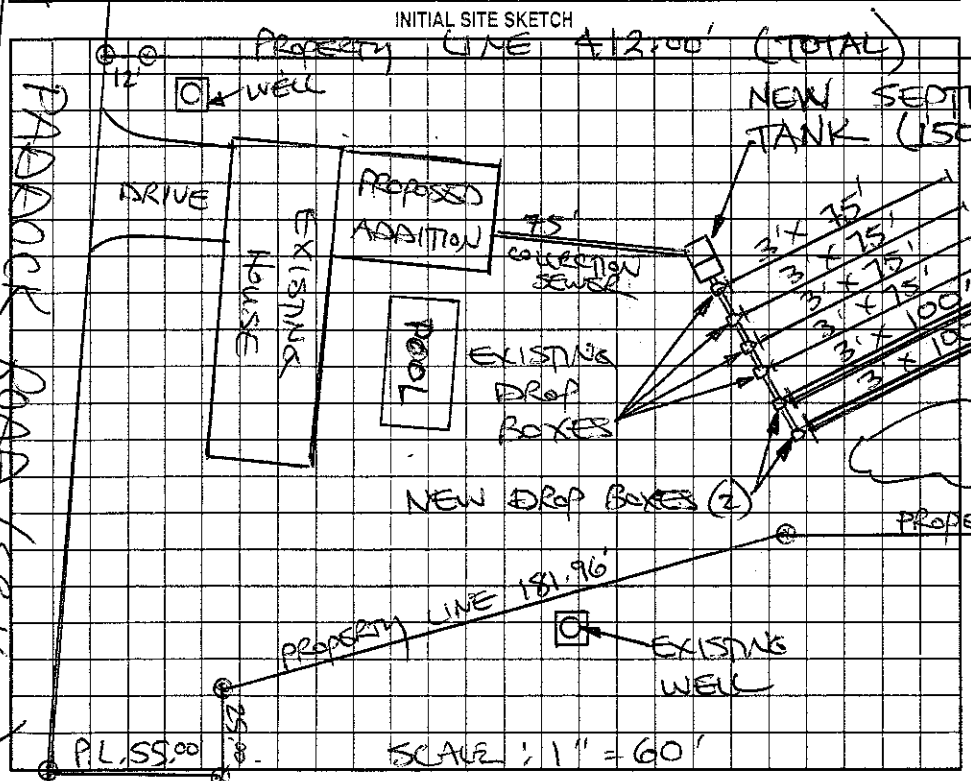


AS BUILT SKETCH

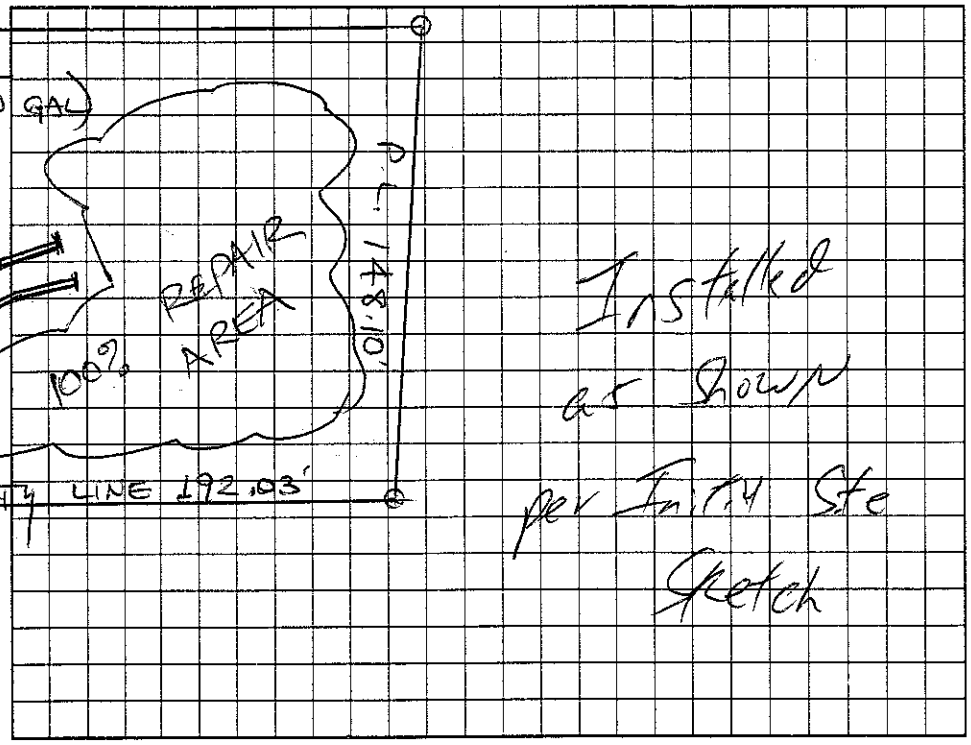


Permit can be suspended or revoked if any false information is supplied toward securing the permit/any unauthorized changes are made to the site/any unauthorized changes are made in the installation of the system. Improvement Permit with plat valid without expiration. Improvement Permit with site plan valid for sixty months. Authorization to Construct is valid for a period equal to that of Improvement Permit – not to exceed sixty months.

Signed: Mary Hope Milligan date 5/12/03 Installed by: A-1 Backhoe

Improvement Permit by: STEVE HEDRICK date 5-13-03 Operation Permit by: William O. Johnson date 5-16-03

Authorization to Construct by: STEVE HEDRICK date 5-13-03 Existing System Inspection by: date

HEALTH DEPT. COPY: WHITE OWNER COPY (FINAL): YELLOW OWNER COPY (INITIAL): PINK