IREDELL COUNTY HEALTH DEPARTMENT

STATESVILLE 704-878-5305 MOORESVILLE 704-664-5281

IMPROVEMENT PERMIT / AUTHORIZATION TO CONSTRUCT / OPERATION PERMIT / EXISTING SYSTEM INSPECTION

PERMIT# 075021 PIN# 4814 65 7035 DATE 7-22-98

OWNER OR CONTRACTOR BRUCE MILLIGAN PHONE: Business (828) 327-7451 Home 592-4900

ADDRESS 192 PADDOCK ROAD, UNION GROVE, NC 28689

LOCATION NC 115 N, TL PADDOCK ROAD, 0.4 MILE, ON RIGHT AT BOX # 192

SUBDIVISION _____ BLOCK / SECTION _____ LOT _____ LOT AREA 1.595 ACRES SITE CLASS. PS DESIGN FLOW 360 L.T.A.R. 0.40 GPD/FT²

Septic Tank: 1000 Gallons; STB 1012 Date 1-3-99

Pump Tank: _____ Gallons; PT _____ Date _____

Pump Make: _____ Model _____ Serial No. _____

Nitrification Field: No. Fields 1 Square Feet 900 Linear Feet 300

No. Lines FOUR Trench Width 36" Max Trench Bottom Depth 36" Gravel Depth 12"

☑ New System ☐ Repair System Type: ☐ I ☐ II ☐ III. IV, V, VI

System Description: CONVENTIONAL GRAVITY

Repair System Description: CONV. GRAVITY

Maintenance Agreement Required: ☐ Yes ☑ No

☐ Slab ☑ Crawl Space ☐ Basement w/plumbing ☐ Basement wo/plumbing

☐ House/Mod. Home No. Bedrooms 3

☑ Mobile Home No. Bathrooms 2

☐ Business No. Employees _____

☐ Other _____


Water Supply: ☑ Individual ☐ Public ☐ Community

WELL


Comments:/Conditions: KEEP SYSTEM MINIMUM 100' FROM ANY WELL SITE (1956(6)(8))

Comments:/Conditions: SEPTIC TANK WITH RISERS INSTALLED WITH "POLY LOK" FILTER

INITIAL SITE SKETCH SCALE: 1" = 60'

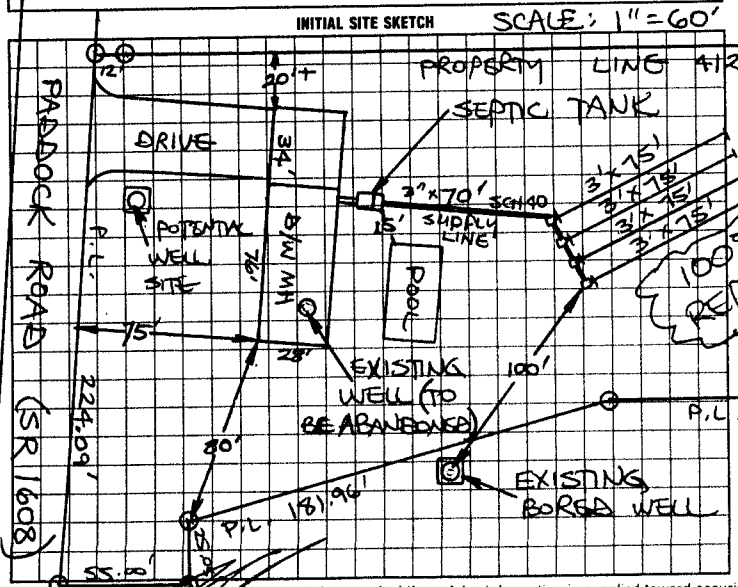

AS BUILT SKETCH

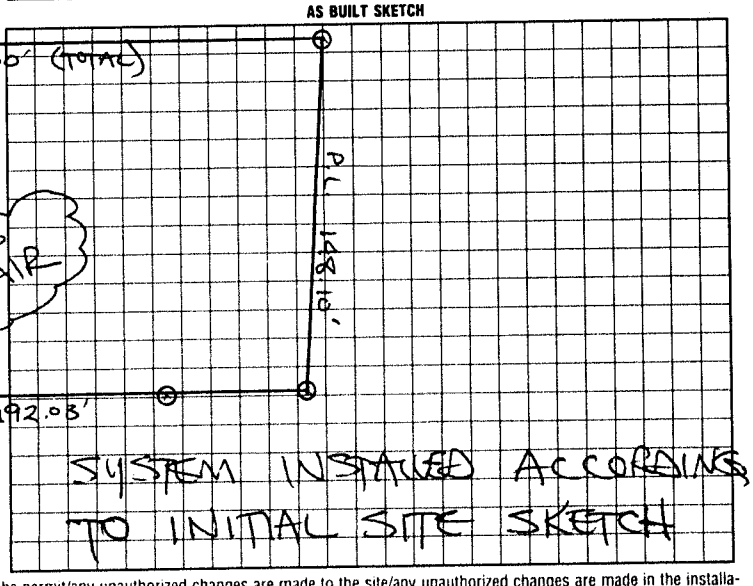

I understand that this permit can be suspended or revoked if any false information is supplied toward securing the permit/any unauthorized changes are made to the site/any unauthorized changes are made in the installation of the system. Improvement Permit with plat valid without expiration. Improvement Permit with site plan valid for sixty months. Authorization to Construct is valid for a period equal to that of Improvement Permit – not to exceed sixty months.

Signed: _____ date 7/22/98 Installed by: A-1 BACKHOE

Improvement Permit by: STEVE HEDRICK date 7-22-98 Operation Permit by: STEVE HEDRICK date 3-18-99

Authorization to Construct by: STEVE HEDRICK date 7-22-98 Existing System Inspection by: _____ date _____

HEALTH DEPT. COPY. WHITE INSPECTION COPY (FINAL) GREEN OWNER COPY (FINAL) YELLOW INSPECTION COPY (INITIAL) PINK OWNER COPY (INITIAL) GOLD