IREDELL COUNTY HEALTH DEPARTMENT

STATESVILLE 704-878-5305 MOORESVILLE 704-664-5281 (C1)

IMPROVEMENT PERMIT / AUTHORIZATION TO CONSTRUCT / OPERATION PERMIT / EXISTING SYSTEM INSPECTION

PERMIT# 109027 PIN# 4814-65-7867 DATE 9-30-02

OWNER OR CONTRACTOR TRAVIS DALE LEWIS PHONE: Business Home 704-592-5731

ADDRESS 8529 WILKESBORO HWY UNION GROVE NC 28689

LOCATION NC115 N, TL PRIVATE DRIVEWAY AT WILKES/COUNTY LINE, BACK OFF ROAD

SUBDIVISION BLOCK / SECTION LOT LOT AREA 2 ACRE SITE CLASS PS DESIGN FLOW 240 L.T.A.R. EXISTING

Septic Tank: EXISTING Gallons: STB Date

Pump Tank: Gallons: PT Date

Pump Make: Model Serial No.

Nitrification Field: No Fields 1 Square Feet Linear Feet EXISTING

No Lines BED Trench Width Max Trench Bottom Depth

☐ New System ☐ Repair System Type: I (II) III IV V VI

System Description: CONVENTIONAL, GRAVITY

Repair System Description:

Maintenance Agreement Required: ☐ Yes ☑ No

Gravel Depth EXISTING ☐ Slab ☑ Crawl Space ☐ Basement w/plumbing ☐ Basement wo/plumbing

☐ House/Mod. Home ☑ Mobile Home ☐ Business ☐ Other


No. Bedrooms 2 No. Bathrooms 2 No. Employees

Water Supply: ☑ Individual ☐ Public ☐ Community WELL NEXT DOOR


Comments/Conditions:

Comments/Conditions: SYSTEM INSTALLED DEEP & NOT TO TODAY'S STANDARDS. SIZED FOR TWO BEDROOM ONLY

INITIAL SITE SKETCH

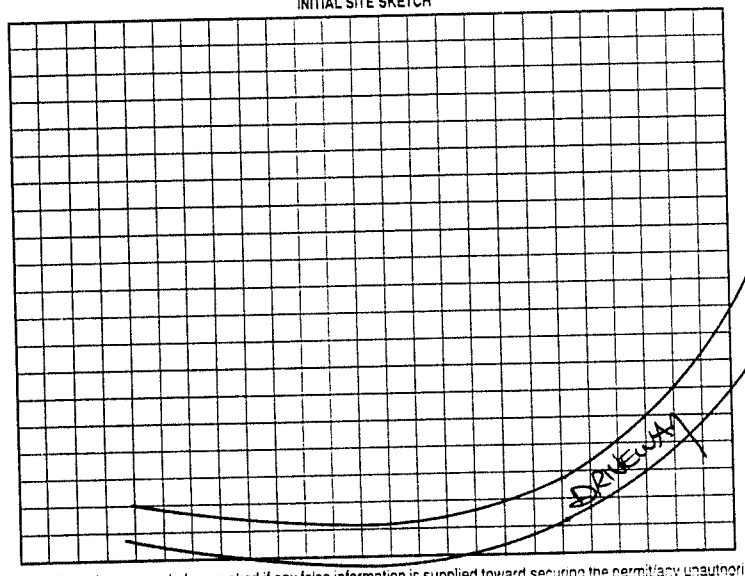

AS BUILT SKETCH

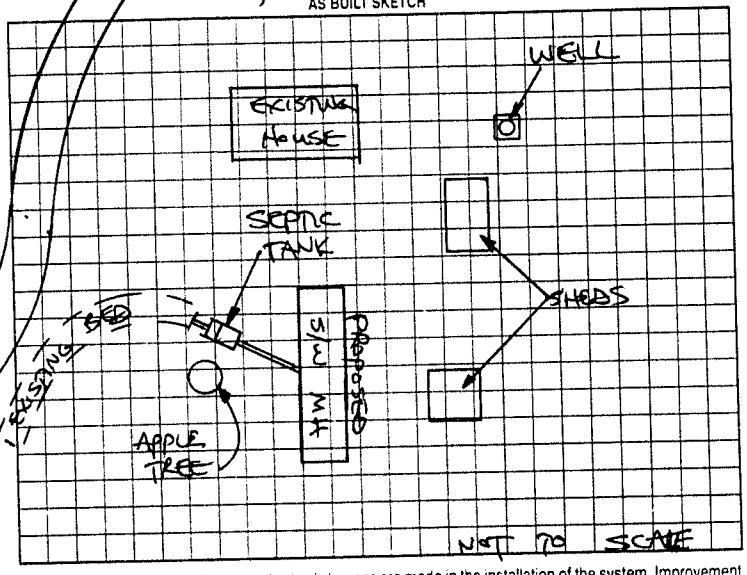

Permit can be suspended or revoked if any false information is supplied toward securing the permit/any unauthorized changes are made to the site/any unauthorized changes are made in the installation of the system. Improvement Permit with plat valid without expiration. Improvement Permit with site plan valid for sixty months. Authorization to Construct is valid for a period equal to that of Improvement Permit – not to exceed sixty months

Signed: date

Improvement Permit by: date

Authorization to Construct by: date

Installed by date

Operation Permit by: date

Existing System Inspection by: STEVE HENDRICK date 9-30-02

HEALTH DEPT COPY: WHITE OWNER COPY (FINAL): YELLOW OWNER COPY (INITIAL): PINK